

21517



APPROVED
LORAIN CO.
MAP DEPT
DATE
PAGE
BY

21517

21517

APPROVED
LORAIN CO.
MAP DEPT
DATE 9-28-95
PAGE 7-00-004-D
BY CAROLYN
FRANCIS
21517

441.98
440.75

108


P.P.NO. 07-00-004-108-
 PRIOR INST:
 CLOSURE: 10.25ac. 0.04:10,000
 0.52ac. 1:INF.
 0.52ac. 1:INF.
 SURVEYED BY: HENRY G.
 REITZ ENG. CO.
 CLOSURE: 26.91ac. 0.40:10,000

21517

072
 PT. 043
 PT. 3806-A
 26.77 A
 26.91 A

Ac. Cont. PER SURVEY
 by Henry G. Reitz Eng. Co.

x 1295.42
 1292
 x 1295.46

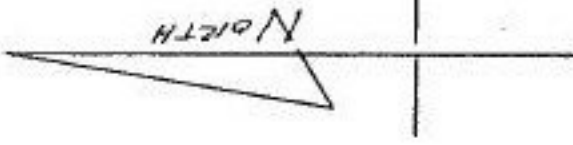

1268
 1740.80
 852.90

-041
 1.68 A

-042
 4.36 A

7.00
 7.00