


#21519-D

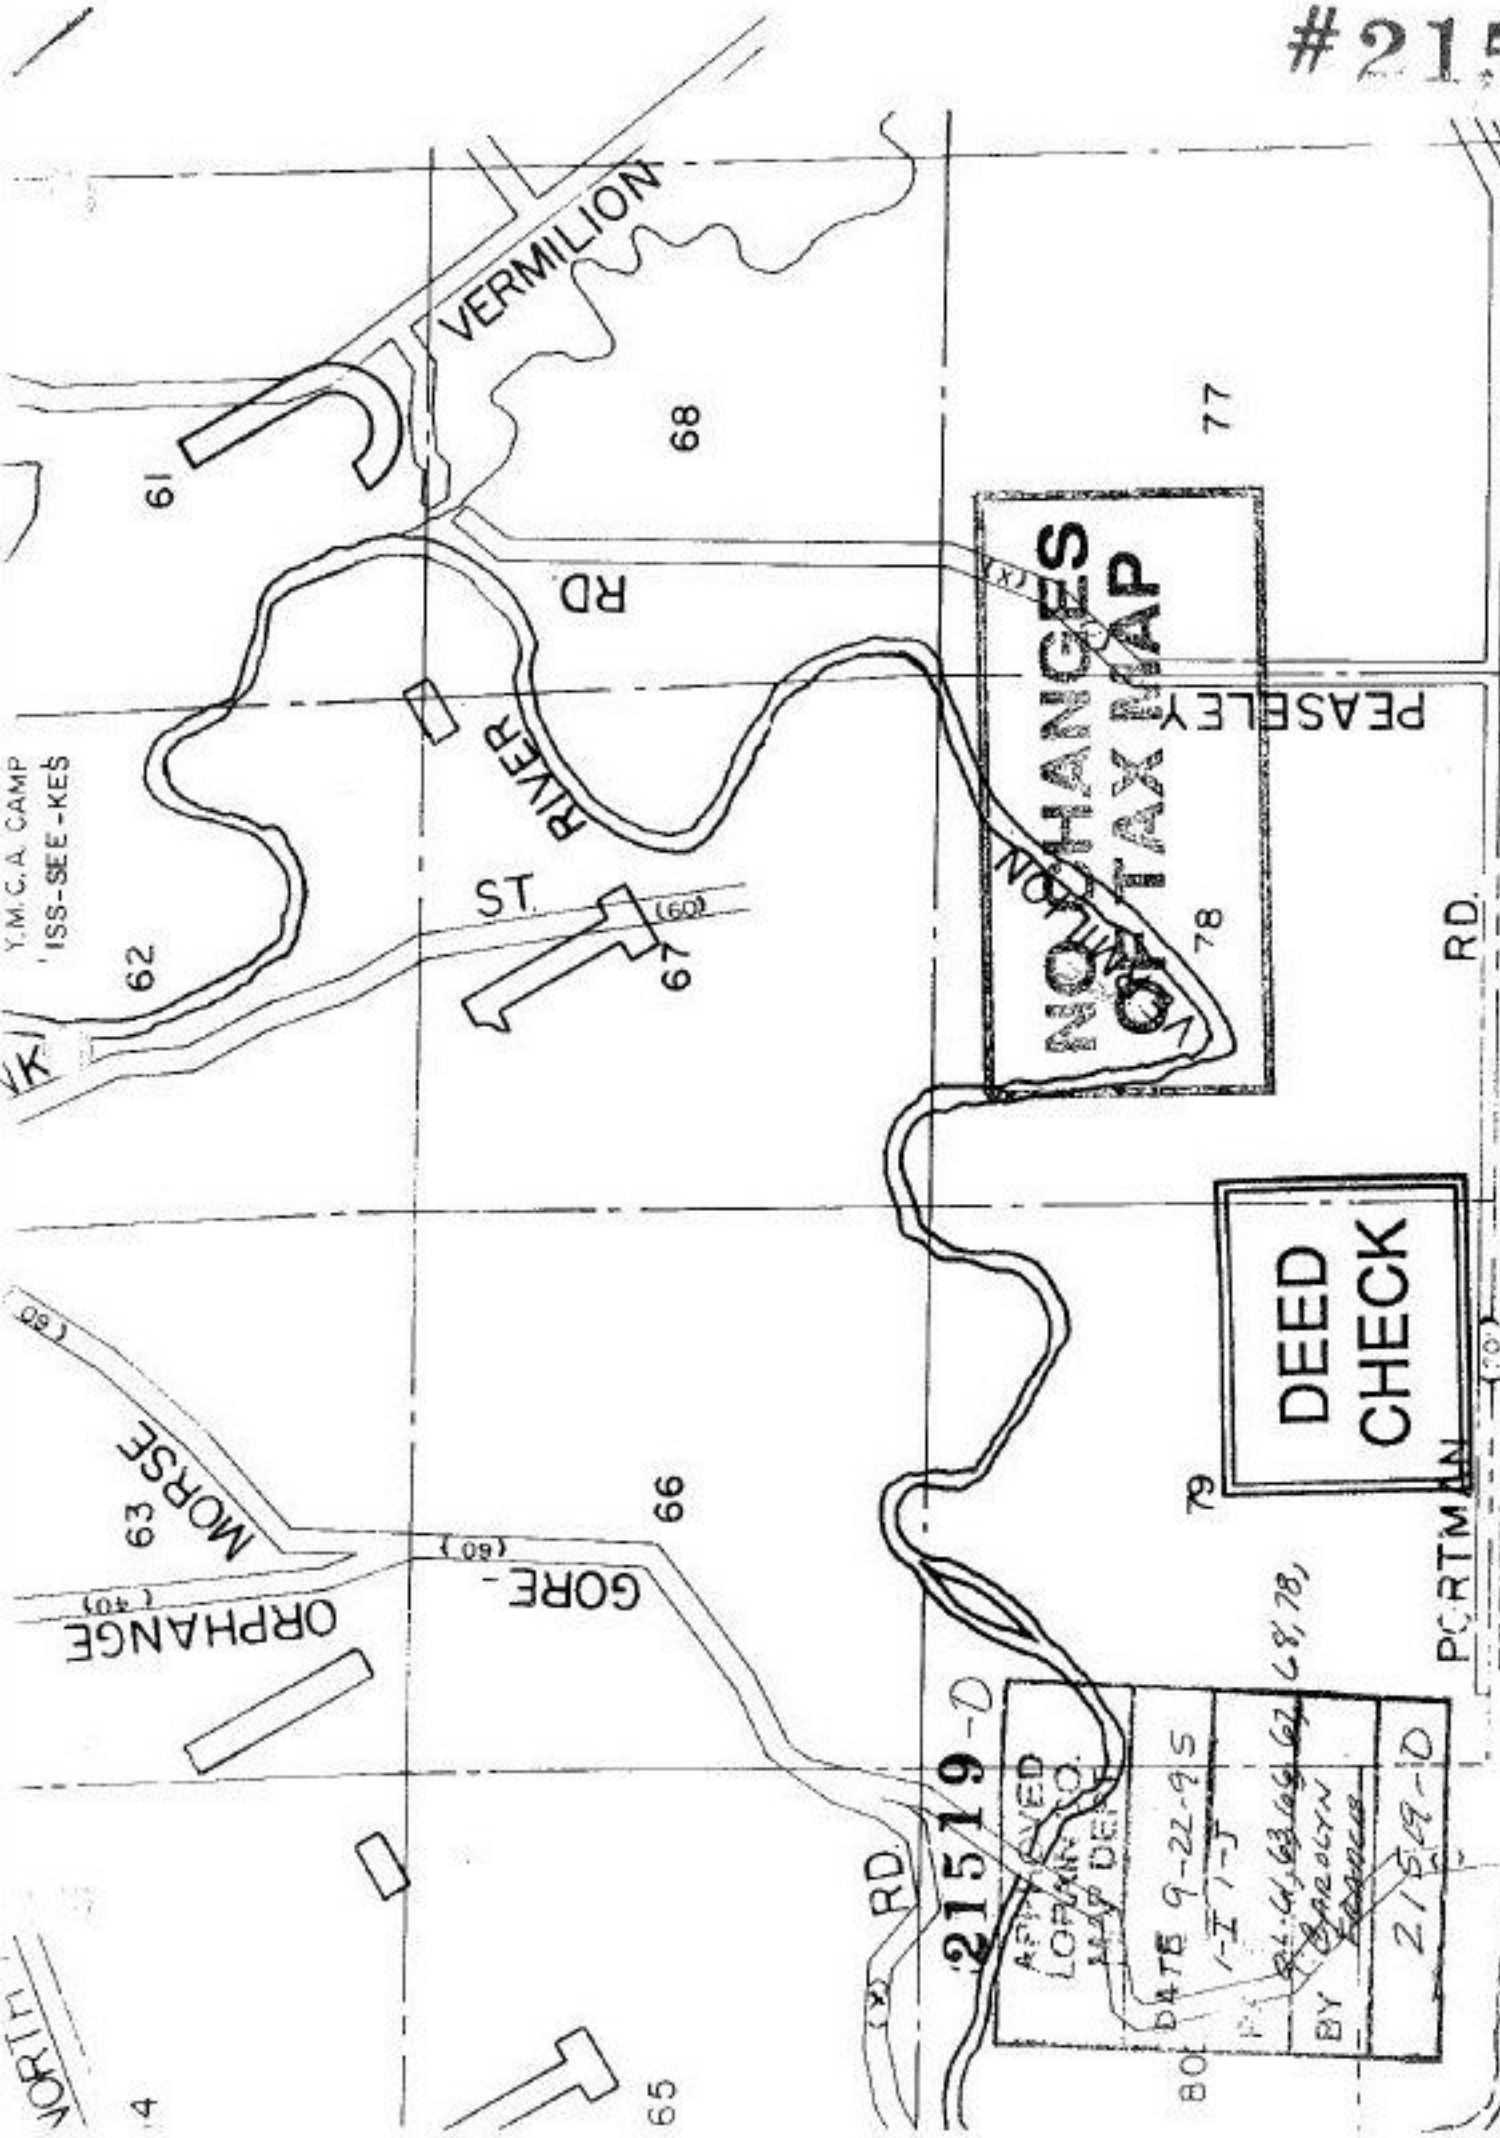

HENRIETTA

SEE \*21499-D

DEEDS CHECK AGAIN