


SEE 10-00-012-D

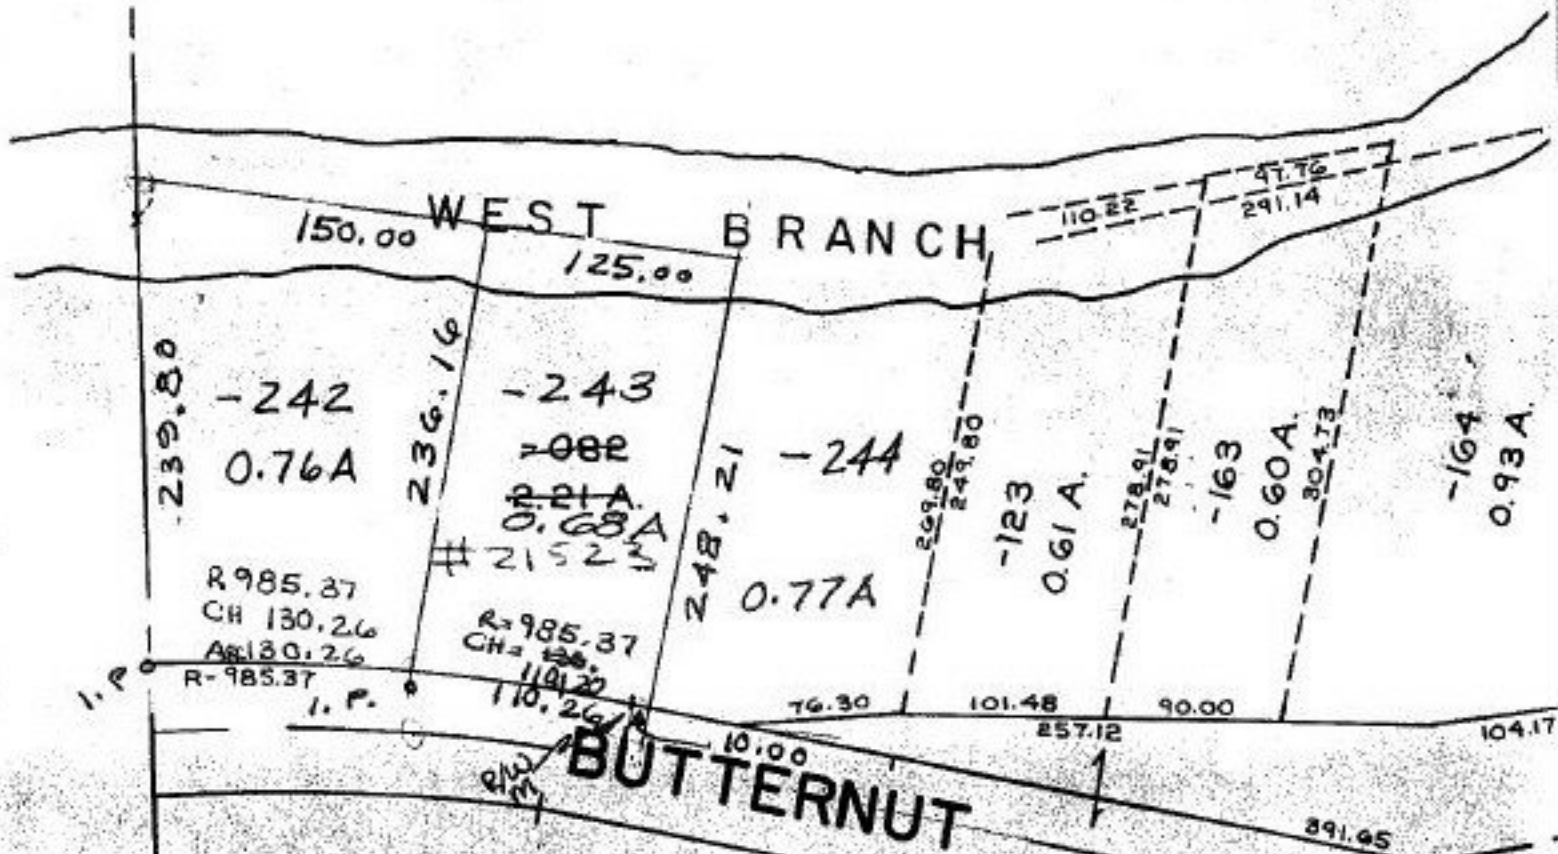

P.P. NO. 10-00-013-000-
 PRIOR INST. BY BIG PG. 639
 CLOSURE: 0.76ac. 0.05:10,000
 0.68ac. 0.07:10,000
 SURVEYED BY: LAUNDON, SIMON
 CAHL & ASSOC.
 ROGER SIMON REG. SURVEYOR

21523
 APPROVED
 LORAIN CO.
 MAP DEPT
 DATE 9-28-95
 PAGE 10-00-013-A
 BY CAROLYN
 FRANCIS
 #21523
 085
 6.5A

-087
3.22 A.

697.75