


MOORE ROAD 60'

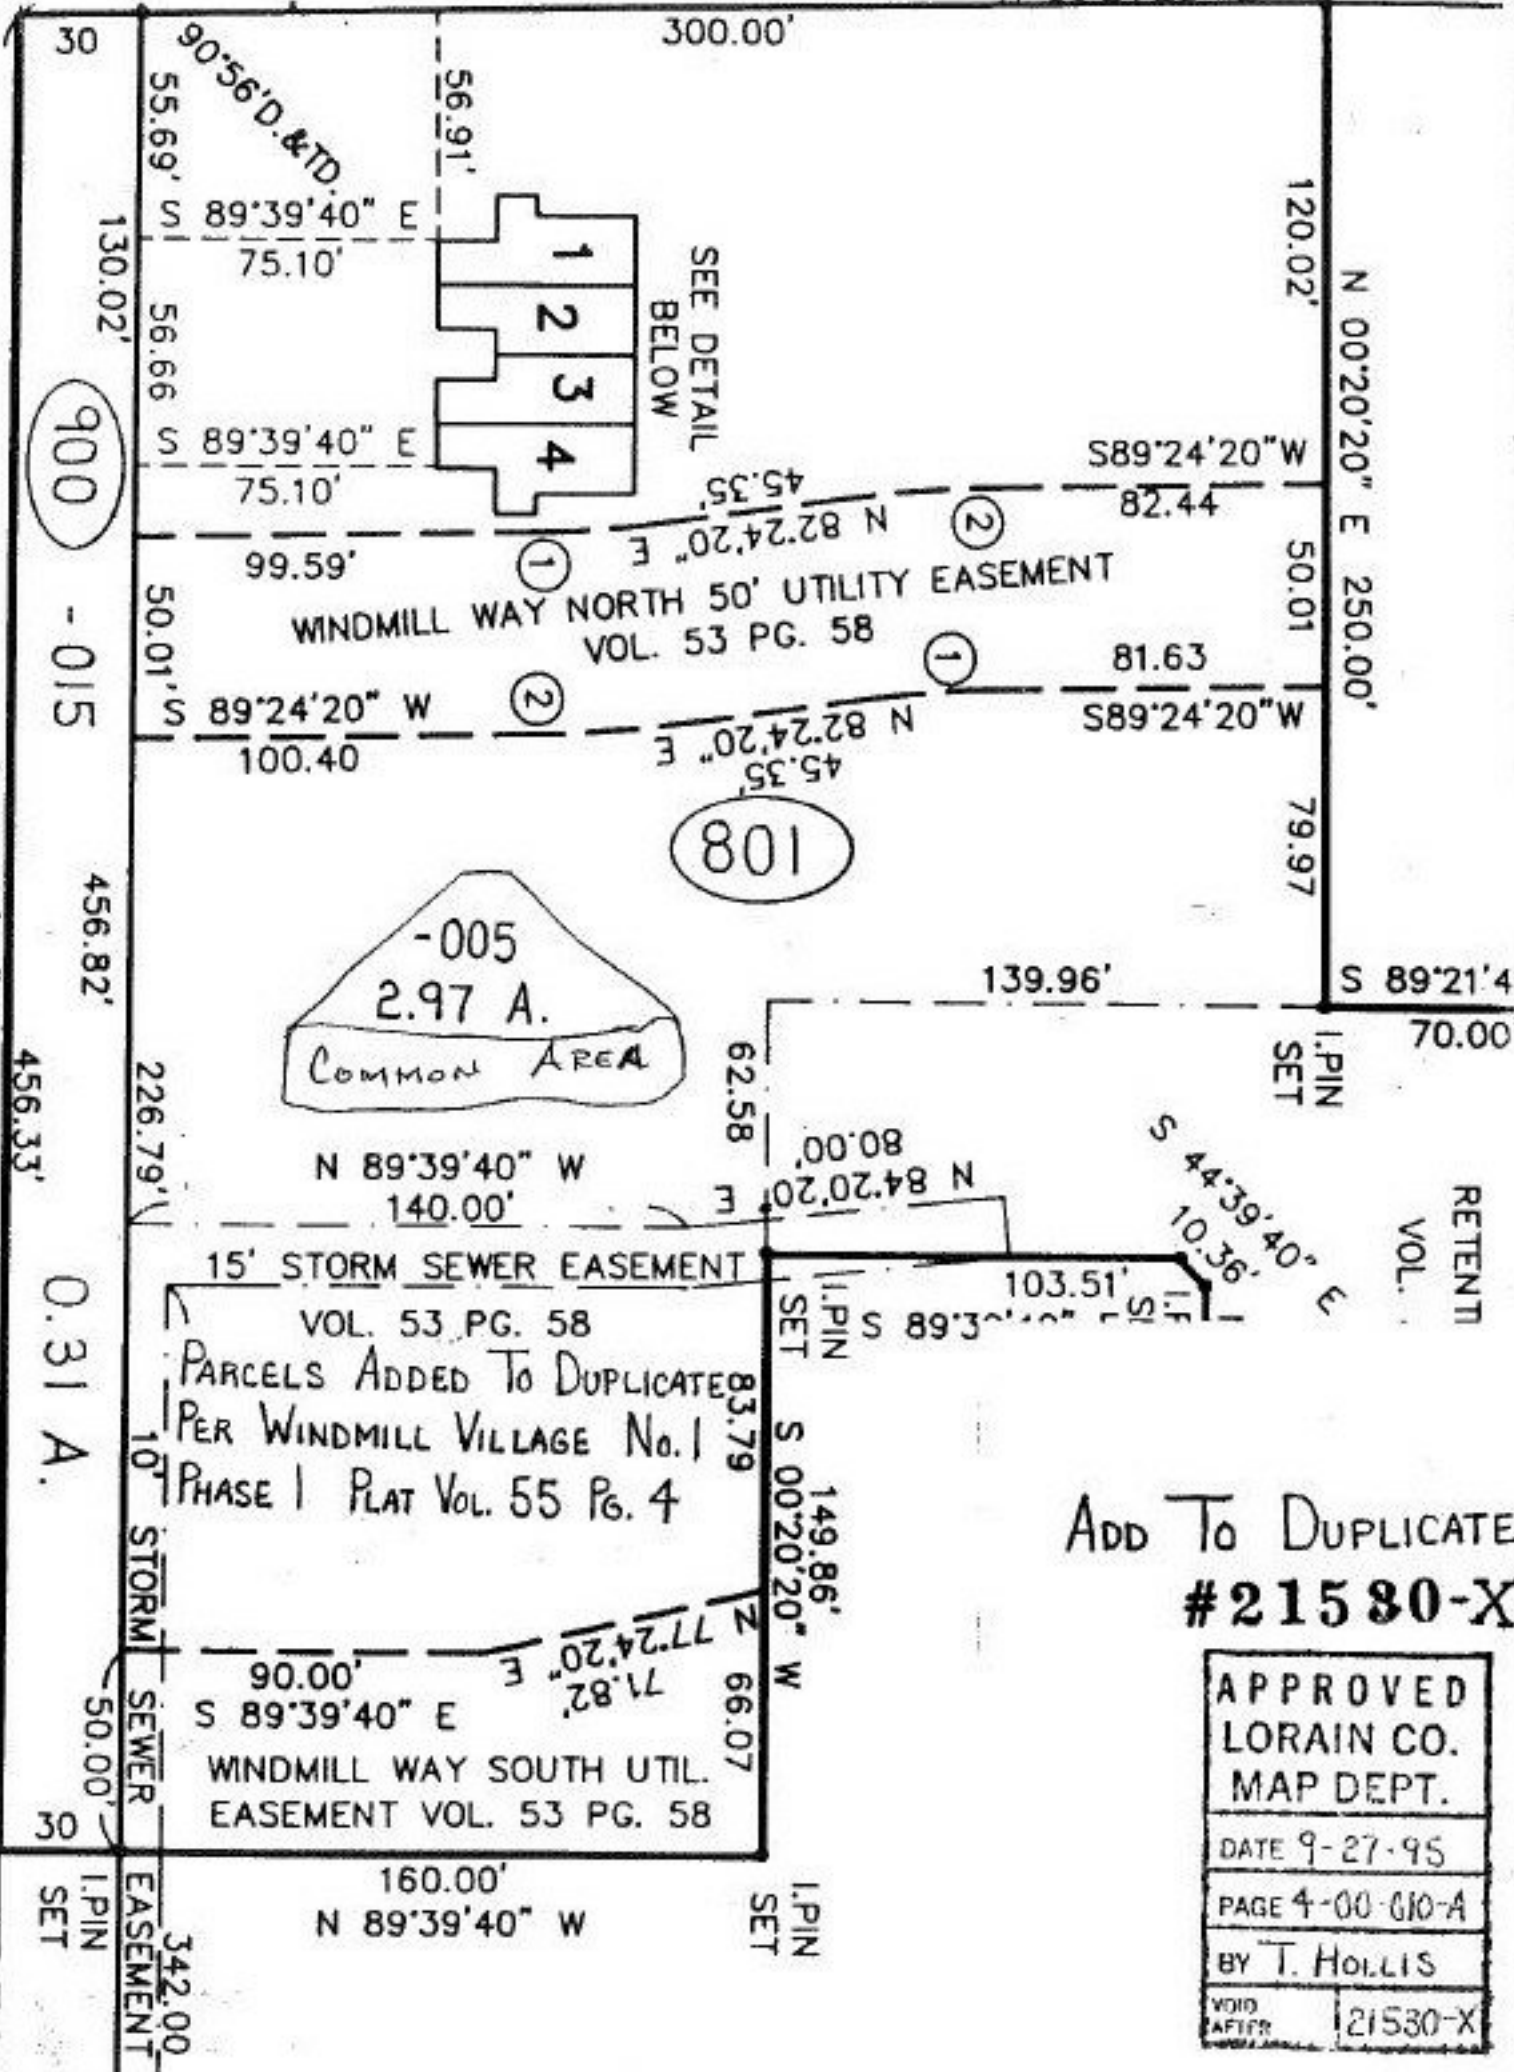

ADD TO DUPLICATE #21580-X

APPROVED LORAIN CO. MAP DEPT.	
DATE 9-27-95	
PAGE 4-00-G10-A	
BY T. HOLLIS	
VOID AFTER	21530-X