


SEE 1-00-003-C

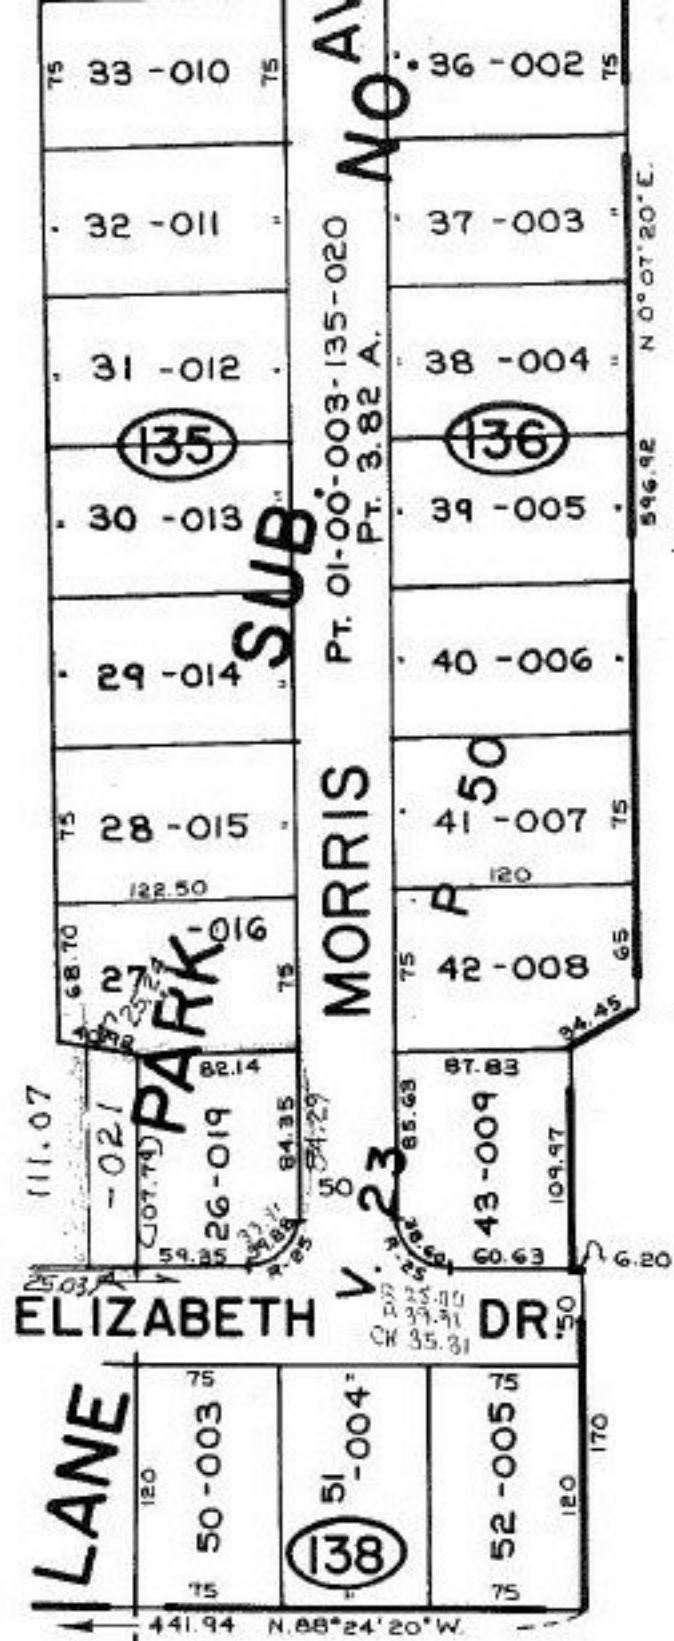

P. P. NO. 01-00-003-135-
 PRIOR INST: (018) O.R. 1103/659
 (017) O.R. 1045/564 (019) O.R. 352/489
 CLOSURE: 0.29:10.000 *Com. 0.30.10.000*
 SURVEYED BY: N.R. HURA
 REG. SURVEYOR

21532

APPROVED
 LORAIN CO.
 MAP DEPT
 DATE 11-17-95
 PAGE 1-00-003-D
 BY CAROLYN
 FRANCIS
 #21532

C SPLIT-018-021, 022
 COMBINE LEGAL DESCRIPTION
 SUBLOT 26-019
 PT. OF 11 25 021

#21532
 SPLIT / COMBINE LEGAL DESCRIPTION