

020-

21-B

PLAT

EAST LOT LINE 20
WEST LOT LINE 17

18-00-020-D
RES 87-245
1294-11


VILLAGE 1294-11
TWP
VILLAGE 87-245
TWP

EAST LOT LINE 21
WEST LOT LINE 16

185.00 -001
183.00A
183.00 A

Ac. PER
DV. 90/346

~PUT IN HOOK ONLY 17

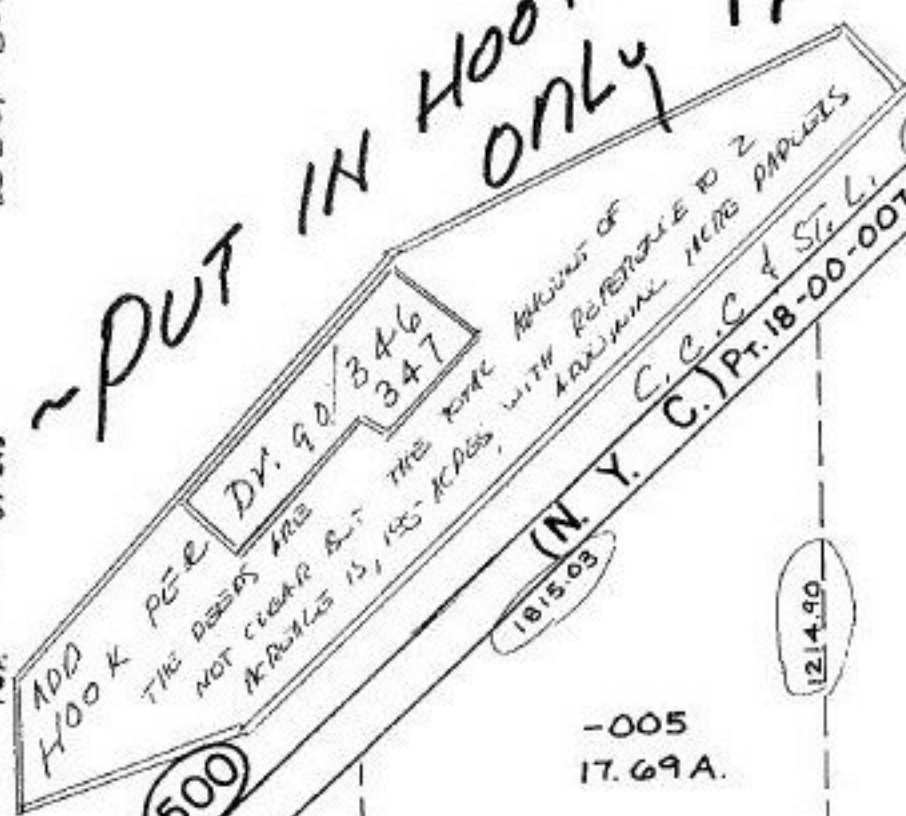

ADD HOOK PER DV. 90/346 347
THE DEEDS ARE NOT CLEAR BUT THE TOTAL ACRES IS 185 ACRES WITH REFERENCE TO 2 ADDITIONAL MORE PAPERS
(N.Y.C.) Pt. 18-00-007-500-001

-005
17.69A.

-003
1.00A.

ALL REFERENCE DEEDS GO TO 3 LINE OCCASION R.R. RIGHT-OF-WAY ONLY HERE TO BE REMOVED FROM NW CORNER OF D.L. 110

PL. CL. 16
THIS CORRECTION "RELOCATES" HOOK TO A PAPER TO NORTH

398.20 21549-A

APPROVED LORAIN CO. MAP DEPT
DATE 10-26-95
PAGE 18-C
BY CAROLYN FRANCIS
21549 A

MAP CORR.

18-0

-C
72