



COMBINATION 21554
649.99 ft. FROM INTERSECTION
OF N. LOT LINE '0BERLIN RD
649.99 TO INT. w/ N. LINE CL. S.C. (N.E. CORNER CL. S.C.)

005
4 A.

PT. 05-00-064-000-069
0.03 - 1481
0.35 differences
187.50
187.15

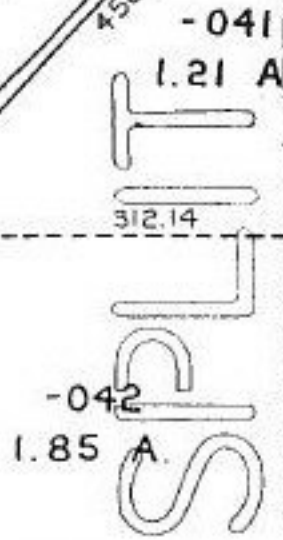

815.50
317.00
-051-053
-007 1.63A 51.50
1.71 A. 1.62A
1.12 A. AC. CORR.
PER SURVEY
390.42 391.92 0. WAKYU
390.42
0.13'

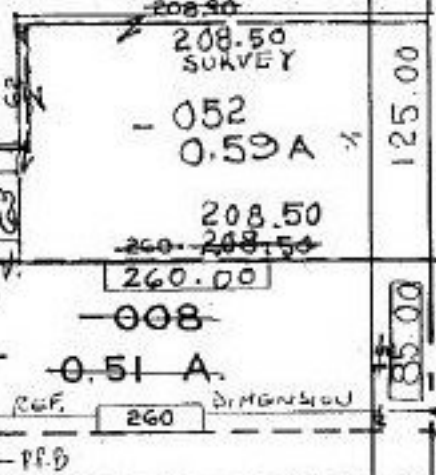

SPLIT -007-1.71A
-051 1.12A
0.52 0.59A

-009 P.P. NO. 05-00-056-000
PRIOR INST: DV. 332/139
(-008) DV. 741/515
CLOSURE: 1.12ac 0.23; 10,000
1.62ac 0.16; 10,000
SURVEYED BY: CHARLES WARYU
REG. SURVEYOR

COMTB: -008 0.51A
-051 1.12A
1.63A
1.62A AC. CORR

-010
2.36 A.

-046
1.62 A.

PLACE OF BEGINNING 600 ft FROM 544.41
INTERSECTION OF OBERLIN RD.
AND N.Y.C.R.R.

501

1053
N. Y. C. R.R.
-003

2.78 A.

21554
APPROVED
LORAIN CO.
MAP DEPT
DATE 11-1-95
PAGE 500-056 B
BY CAROLYN
FRANCIS
21554

TO CL. OF
SVC. YEARS
(COUNT) OBERLIN ROAD