

21576-D

437.93
519.93


-030
BLK. A.

VOL. 24

ACRES
ACREAGE
CORRECTION

-031

414.93

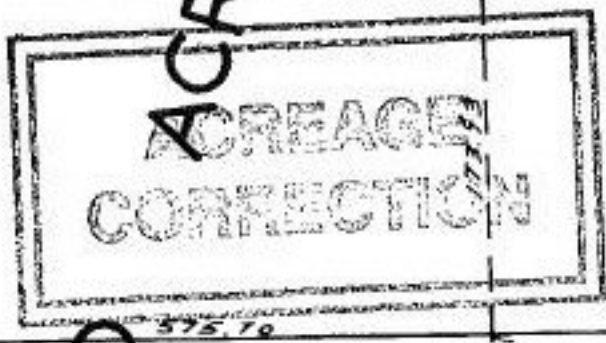

Pt. 03-00-100-900-001
1280.70

ST. 80

Pt. 5.58A.



OAKWOOD

SENEGA



#21576-D
-023
1.50 A.
1.08 A.

325.07
-021
0.63 A.
325.07
-022
0.37 A.
(325.07)

AC. CORR PER Surveyed Deed
BY K.S. & Assoc. June 1985
C-1 INF

SEE 3-00-105-A

03-00-100-113-023

SHEFFI

SCALE 1" = 100'

21576-D

APPROVED LORAIN CO. MAP DEPT
DATE 12-12-95
PAGE 3-00-100 A
BY CAROLYN FRANCIS
#21576 D