


21578

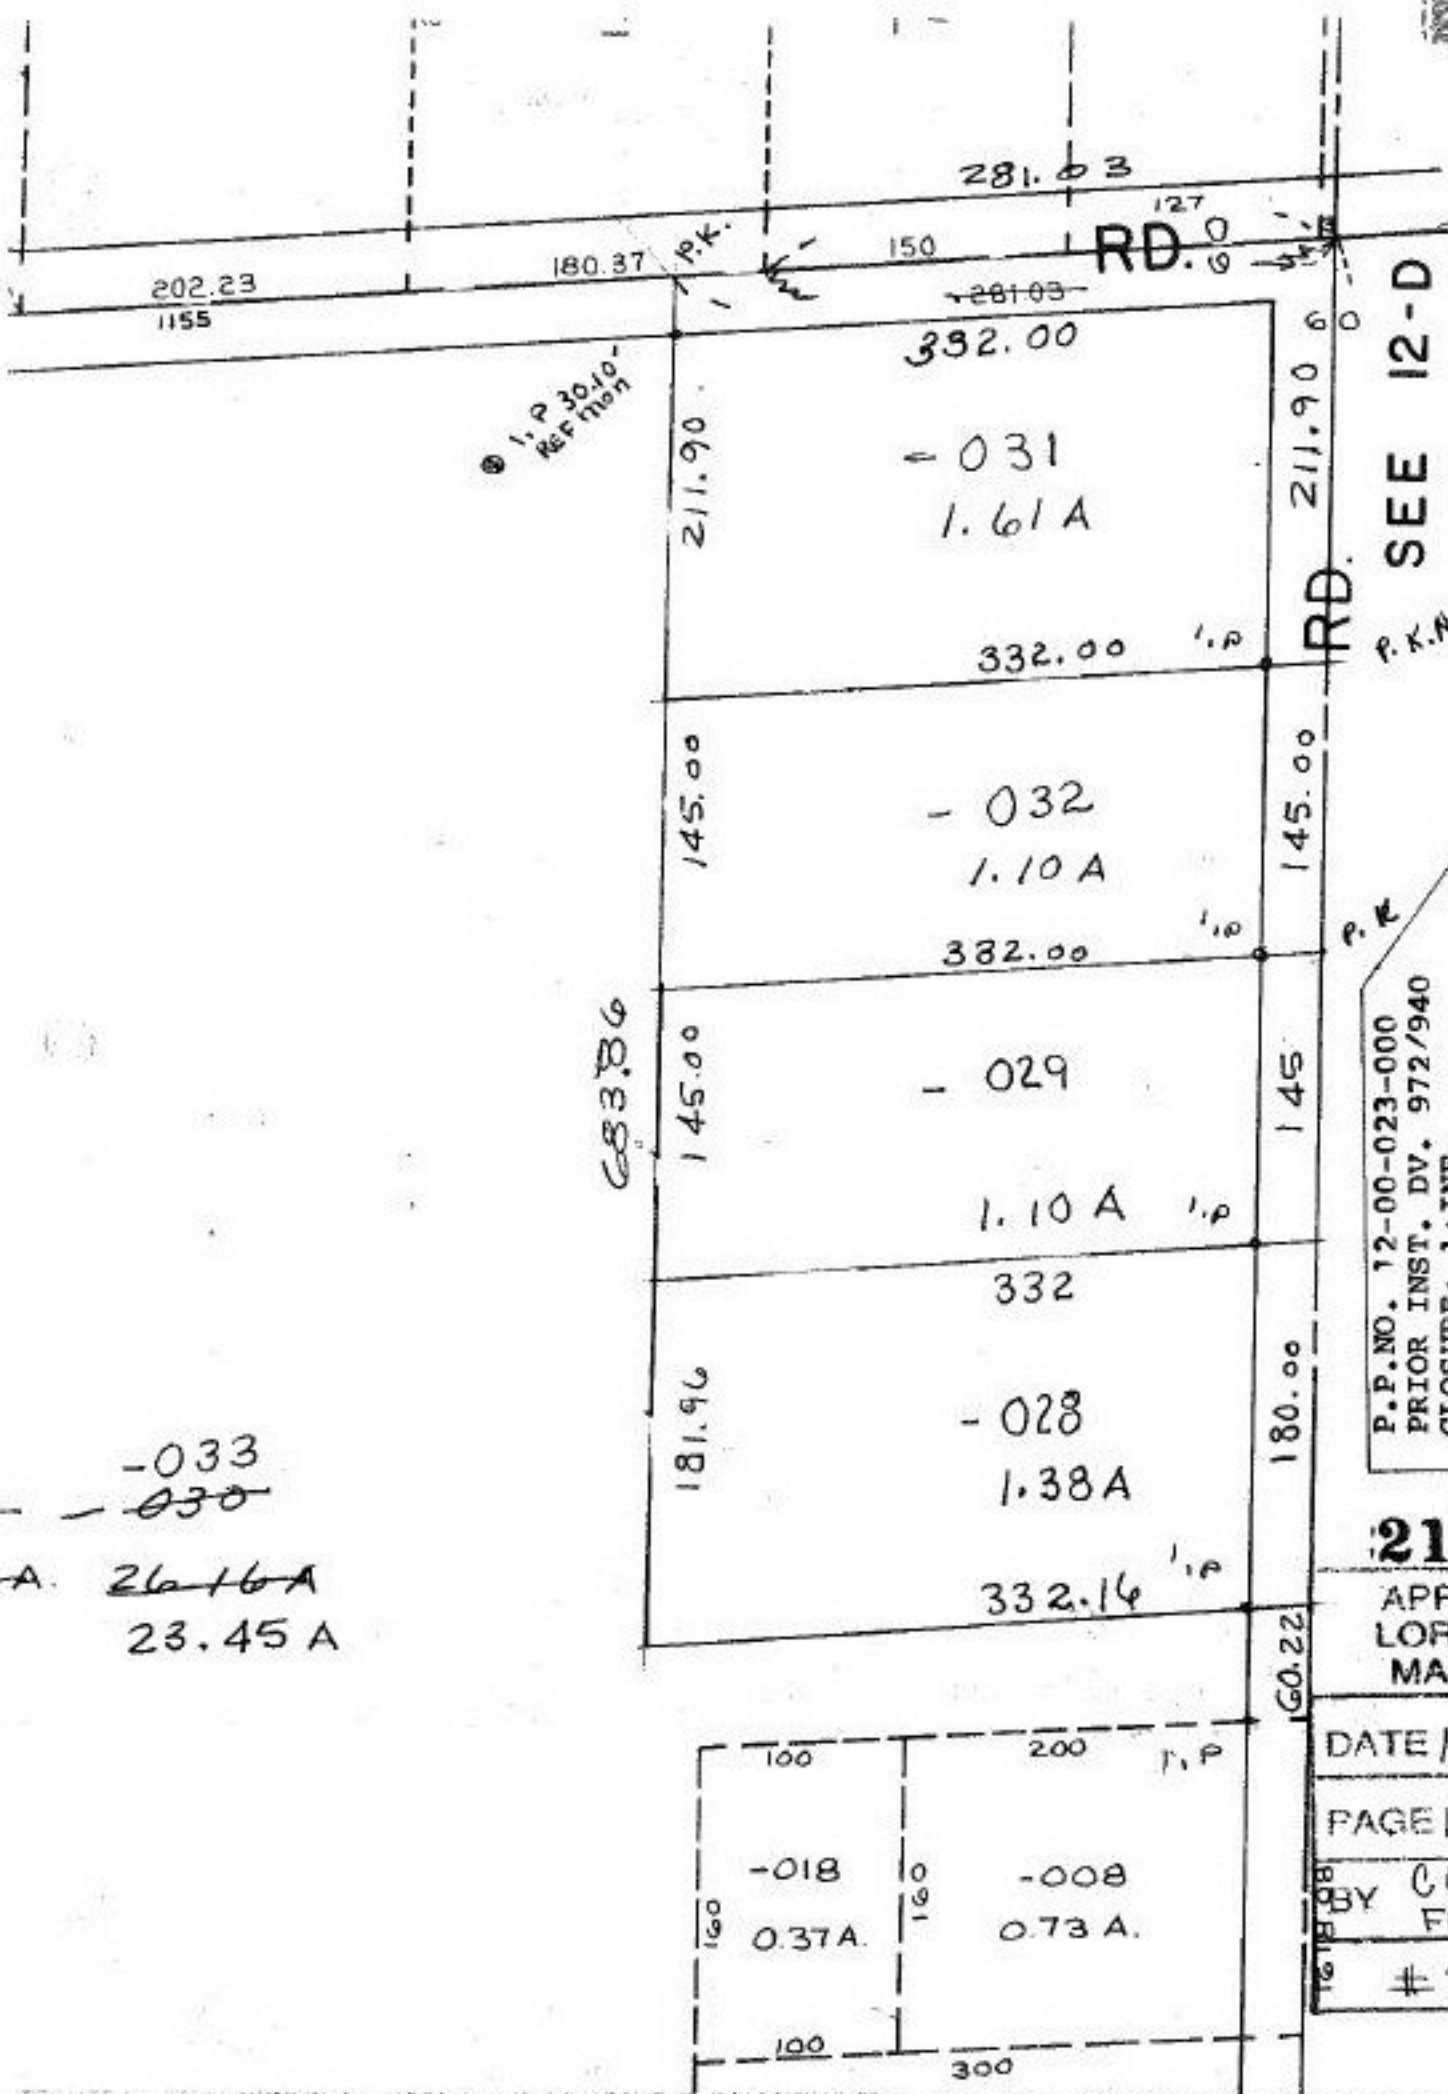

SEE 12-D

P.K. MAIL

P.P. NO. 12-00-023-000
 PRIOR INST. DV. 972/940
 CLOSURE: 1: INF.
 SURVEYED BY: JAMES B. ROBERTS
 REG. SURVEYOR

21578

APPROVED LORAIN CO. MAP DEPT
DATE 12-1-95
PAGE 12-00-023 B
BY CAROLYN FRANCIS
21578

-033
~~-030~~
 A. 26.16A
 23.45A

683.86

1-P 30.10 REF MARK

RD. 127

RD. 12-D

P.K.

160.22

