

DEED 1 12-00-025-000-055 straight transfer 4.00ac

2 SPLIT OUT OF
 052 6.66ac 054 12.01ac
 3.90ac 0.35ac
 no number assigned 2.76ac 11.66ac
 0.35ac
 -056 4.25ac 057 11.66ac

3 SPLIT OUT OF:
 -051 5.15ac.
 -058 -1.12ac.
 -059 4.03ac.

4 SPLIT OUT OF:
 (052) 2.76ac.
 -053 9.93ac.
 -055 4.00ac.
 16.59ac.
 -050 16.67ac.
 -051 0.02ac.

split rem. of (052) 051

21581
 APPROVED
 LORAIN CO.
 MAP DEPT


DATE 12-1-95
 PAGE 12-00-025-8
 BY CAROLYN FRANCIS
 #21581

DEED 5 COMBINATION OF:
 12-00-025-000-057 11.66ac.
 053 1.12ac.
 061 0.02ac.
 -052 12.80ac.
 AC. CORRECTION PER SURVEY

12.78 A PER SAUG
 GEORGE HOFFMANN REG. SURVEYOR
 C=0.0110,000

21581
 APPROVED
 LORAIN CO.
 MAP DEPT

DATE 12-1-95
 PAGE 12-00-025-8
 BY CAROLYN FRANCIS
 #21581

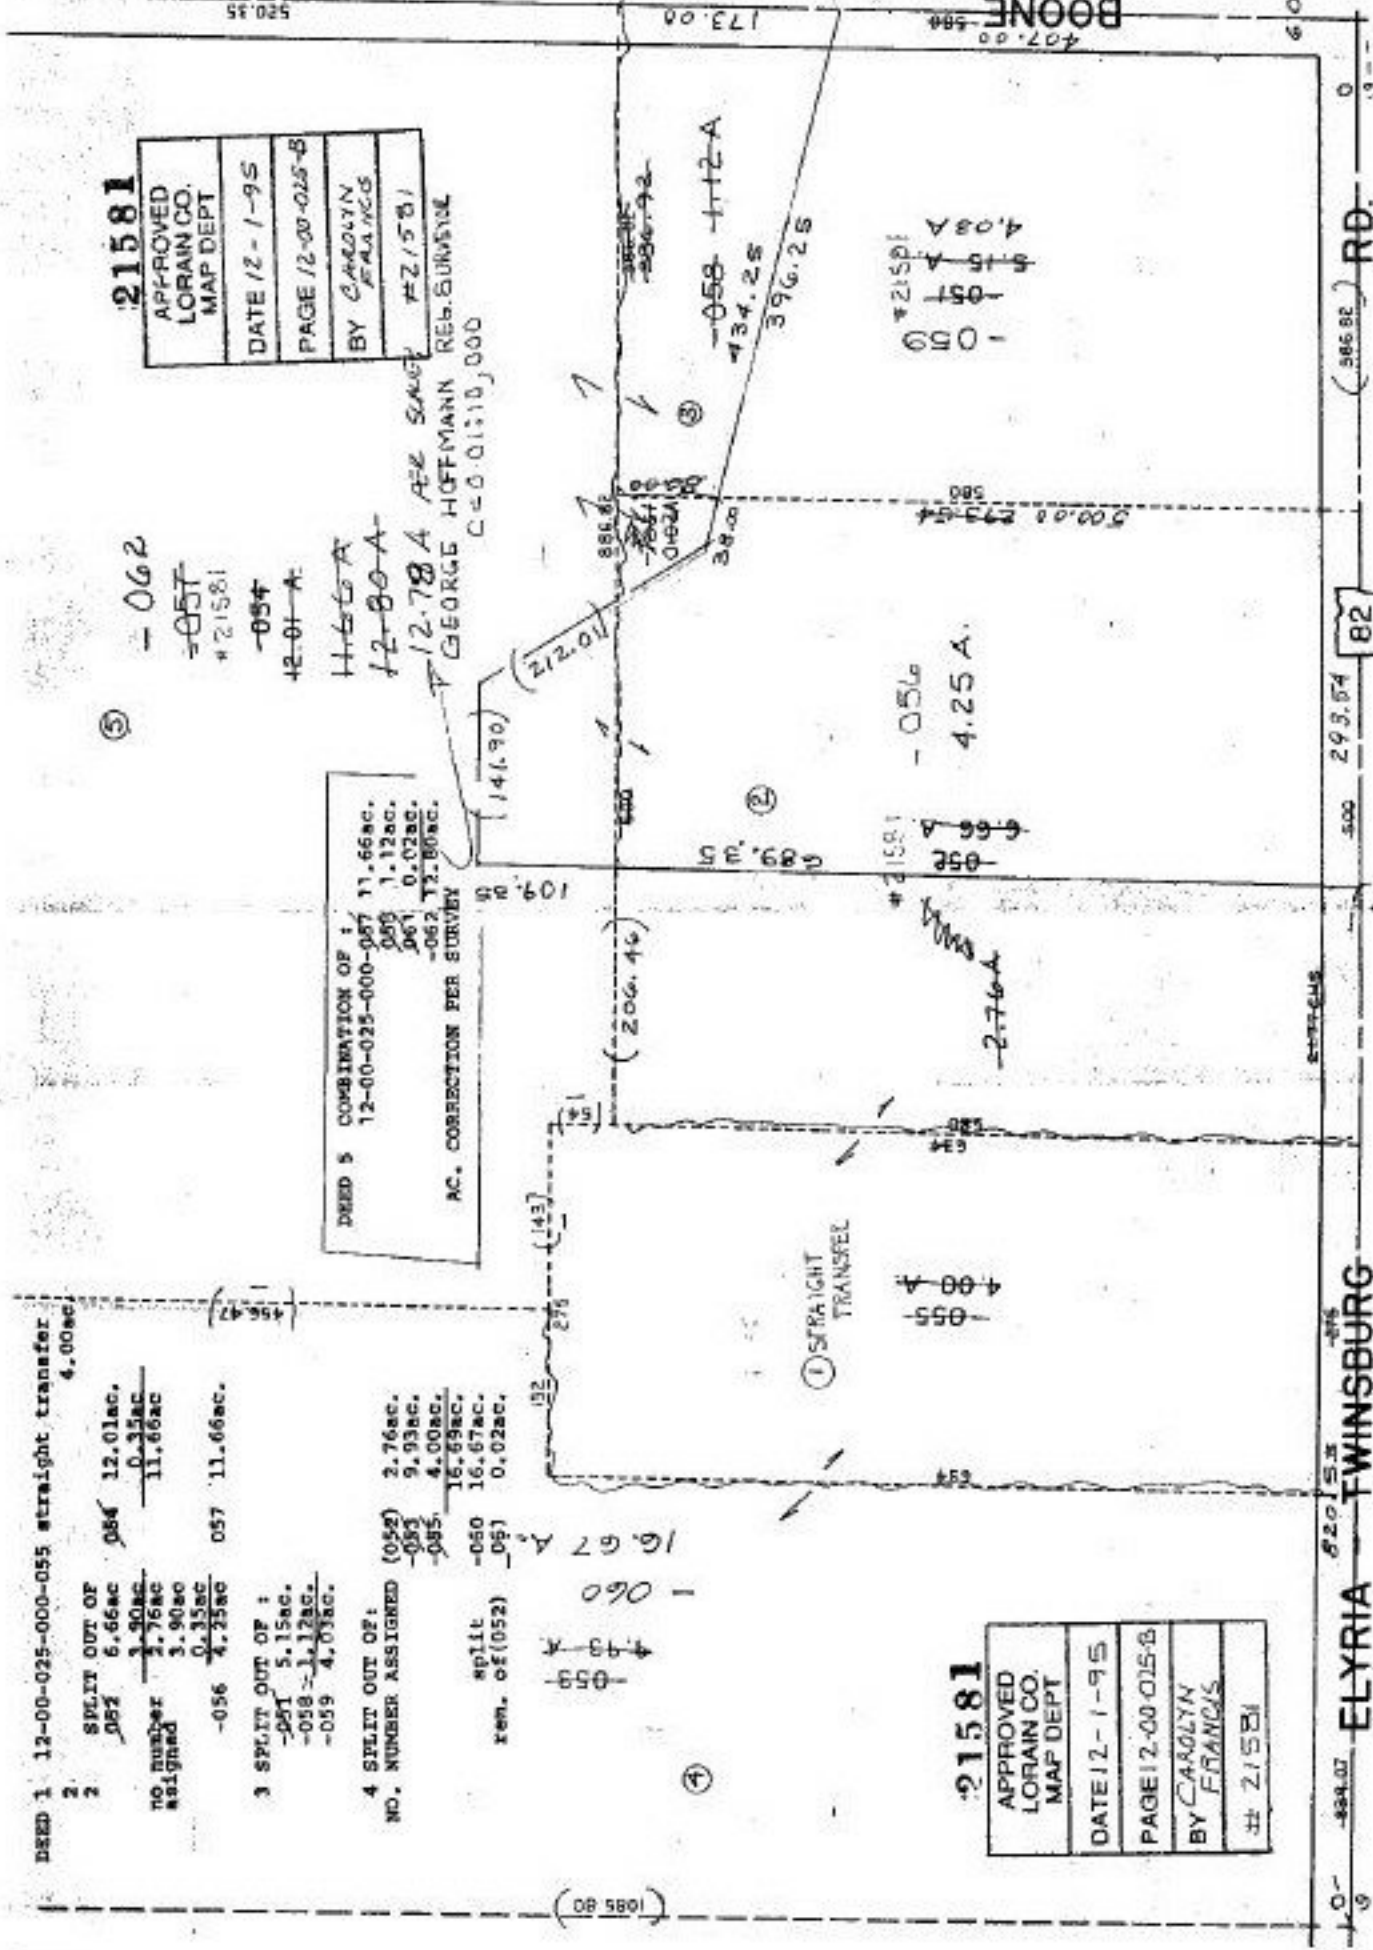

ELYRIA TWINSBURG
 820.55
 829.07

293.54
 82

RD.
 (366.82)

18581

520 35

173.00

BOONE
 407.00
 584