

21584-X
(W. MAIN

ADD TO DUPLICATE

P. 88
S. 88

REFERENCE
DU 348/515


OR 460/15

OR 461/911

LAND INTO
PARK ST. SUB.
PV 36/1

101

BLK
8

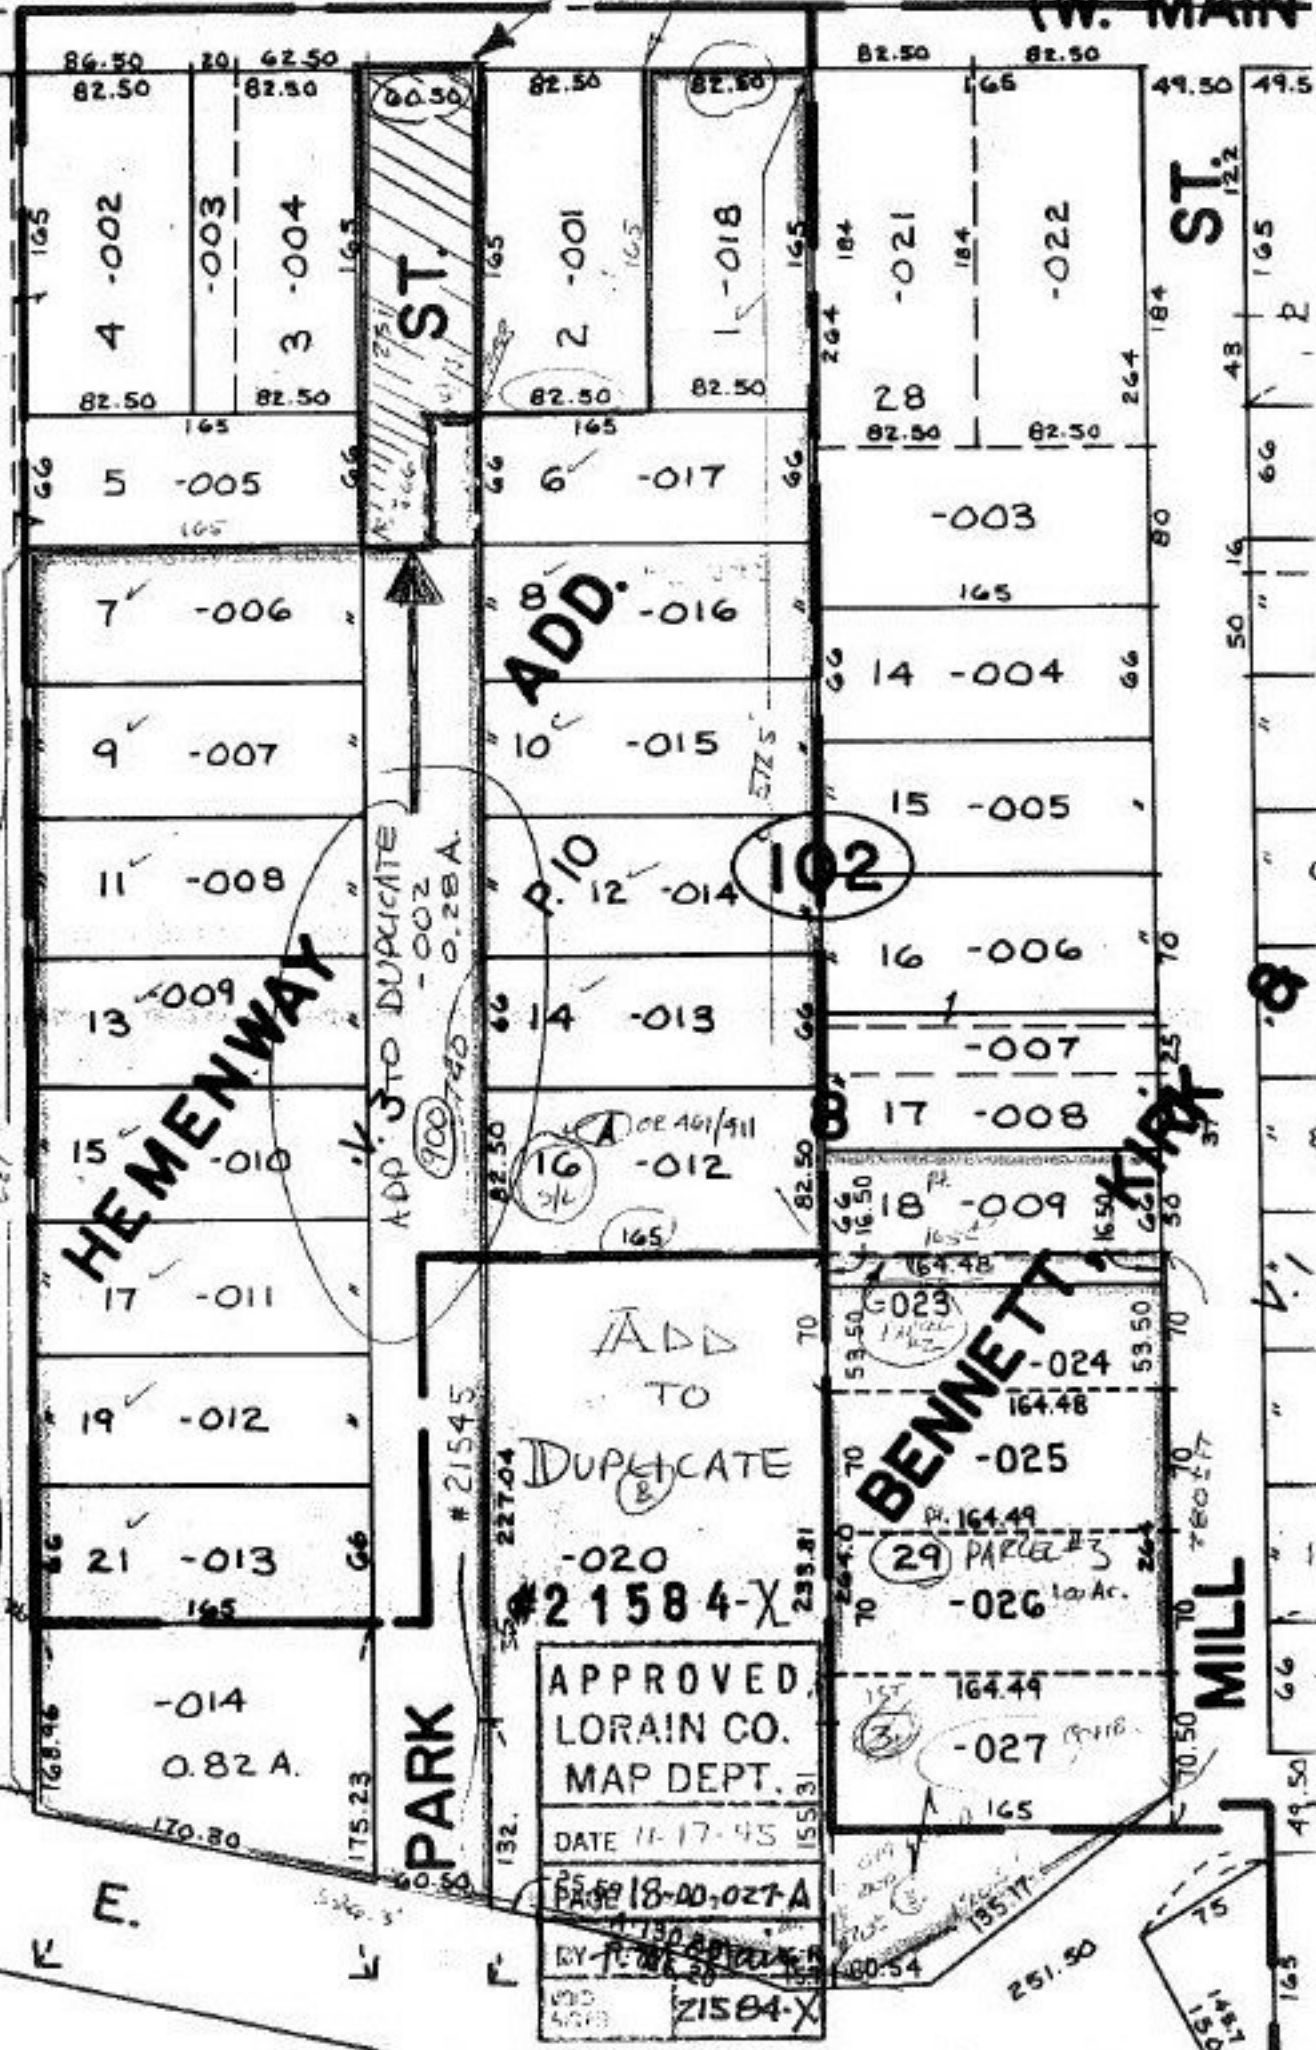

APPROVED
LORAIN CO.
MAP DEPT.
DATE 11-17-45
PAGE 18-00-027-A
BY [Signature]
21584-X

BENNETT ST.
MILL ST.

HEMENWAY

ADD. 3 TO DUPLICATE
-002
0.28A
100-740

ADD.

102

ADD TO DUPLICATE

21584-X

APPROVED
LORAIN CO.
MAP DEPT.

DATE 11-17-45

PAGE 18-00-027-A

BY [Signature]

21584-X