


FC

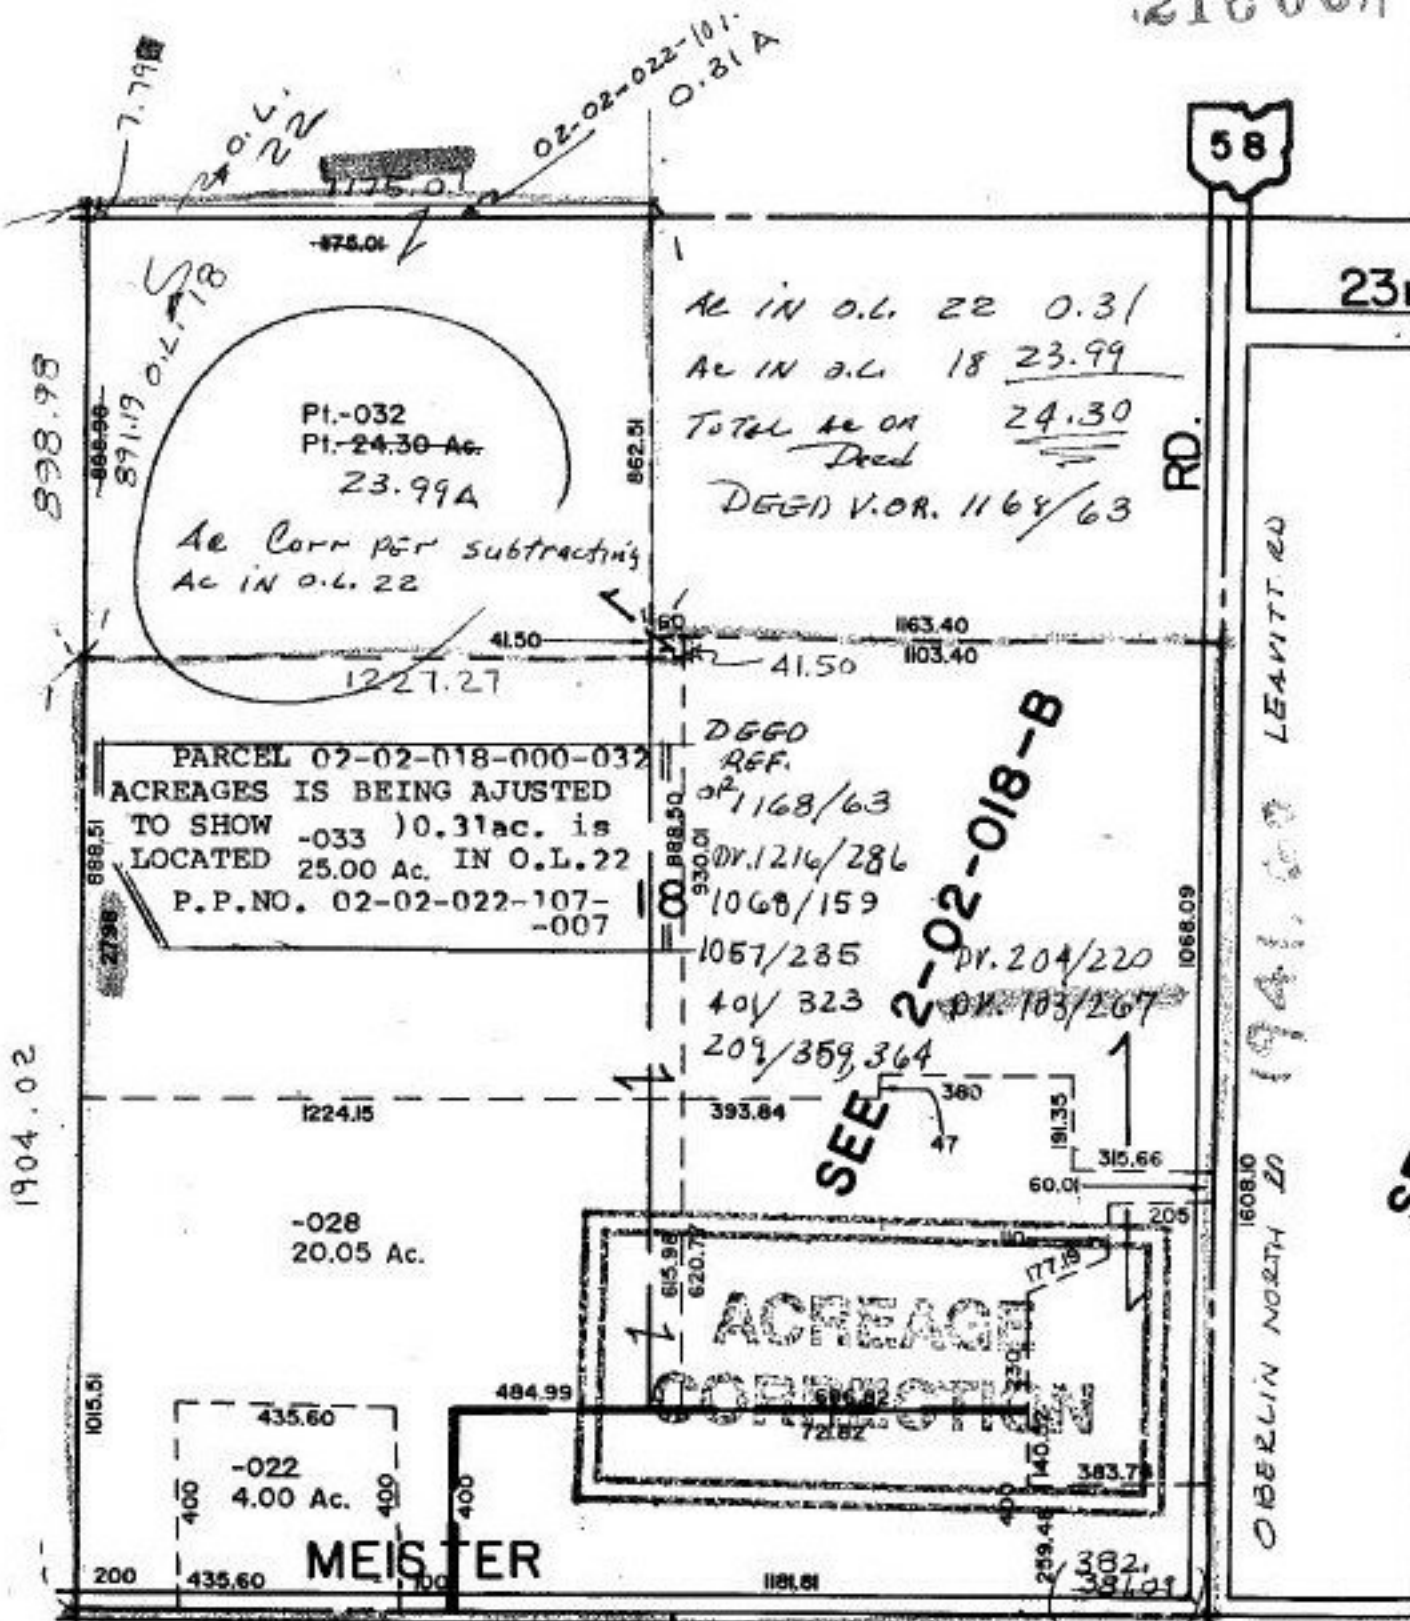

Ac IN O.L. 22 0.31  
 Ac IN O.L. 18 23.99  
 Total Ac on Deed 24.30  
 DEED V.O.R. 1164/63

PARCEL 02-02-018-000-032  
 ACREAGES IS BEING AJUSTED  
 TO SHOW -033 ) 0.31ac. is  
 LOCATED 25.00 Ac. IN O.L. 22  
 P.P.NO. 02-02-022-107-  
 -007

DEED REF.  
 DV 1168/63  
 DV 1216/286  
 1068/159  
 1057/285  
 40/323  
 209/359,364  
 DV 204/220  
 DV 103/267

SEE 2-02-018-B

ACREAGE CORRECTION

-022  
 4.00 Ac.

MEISTER

OBERLIN NORTH RD 1941.60 LEAVITT RD

DV 103/267

APPROVED  
 LORAIN CO.  
 MAP DEPT  
 DATE 12-22-95  
 PAGE 2-G  
 BY CAROLYN  
 FRANCIS  
 21600-A

-A