


-001 ST DELIVERABLE PLAN
18.50 A. Vol. 46 Pgs 10 & 11
1424.96

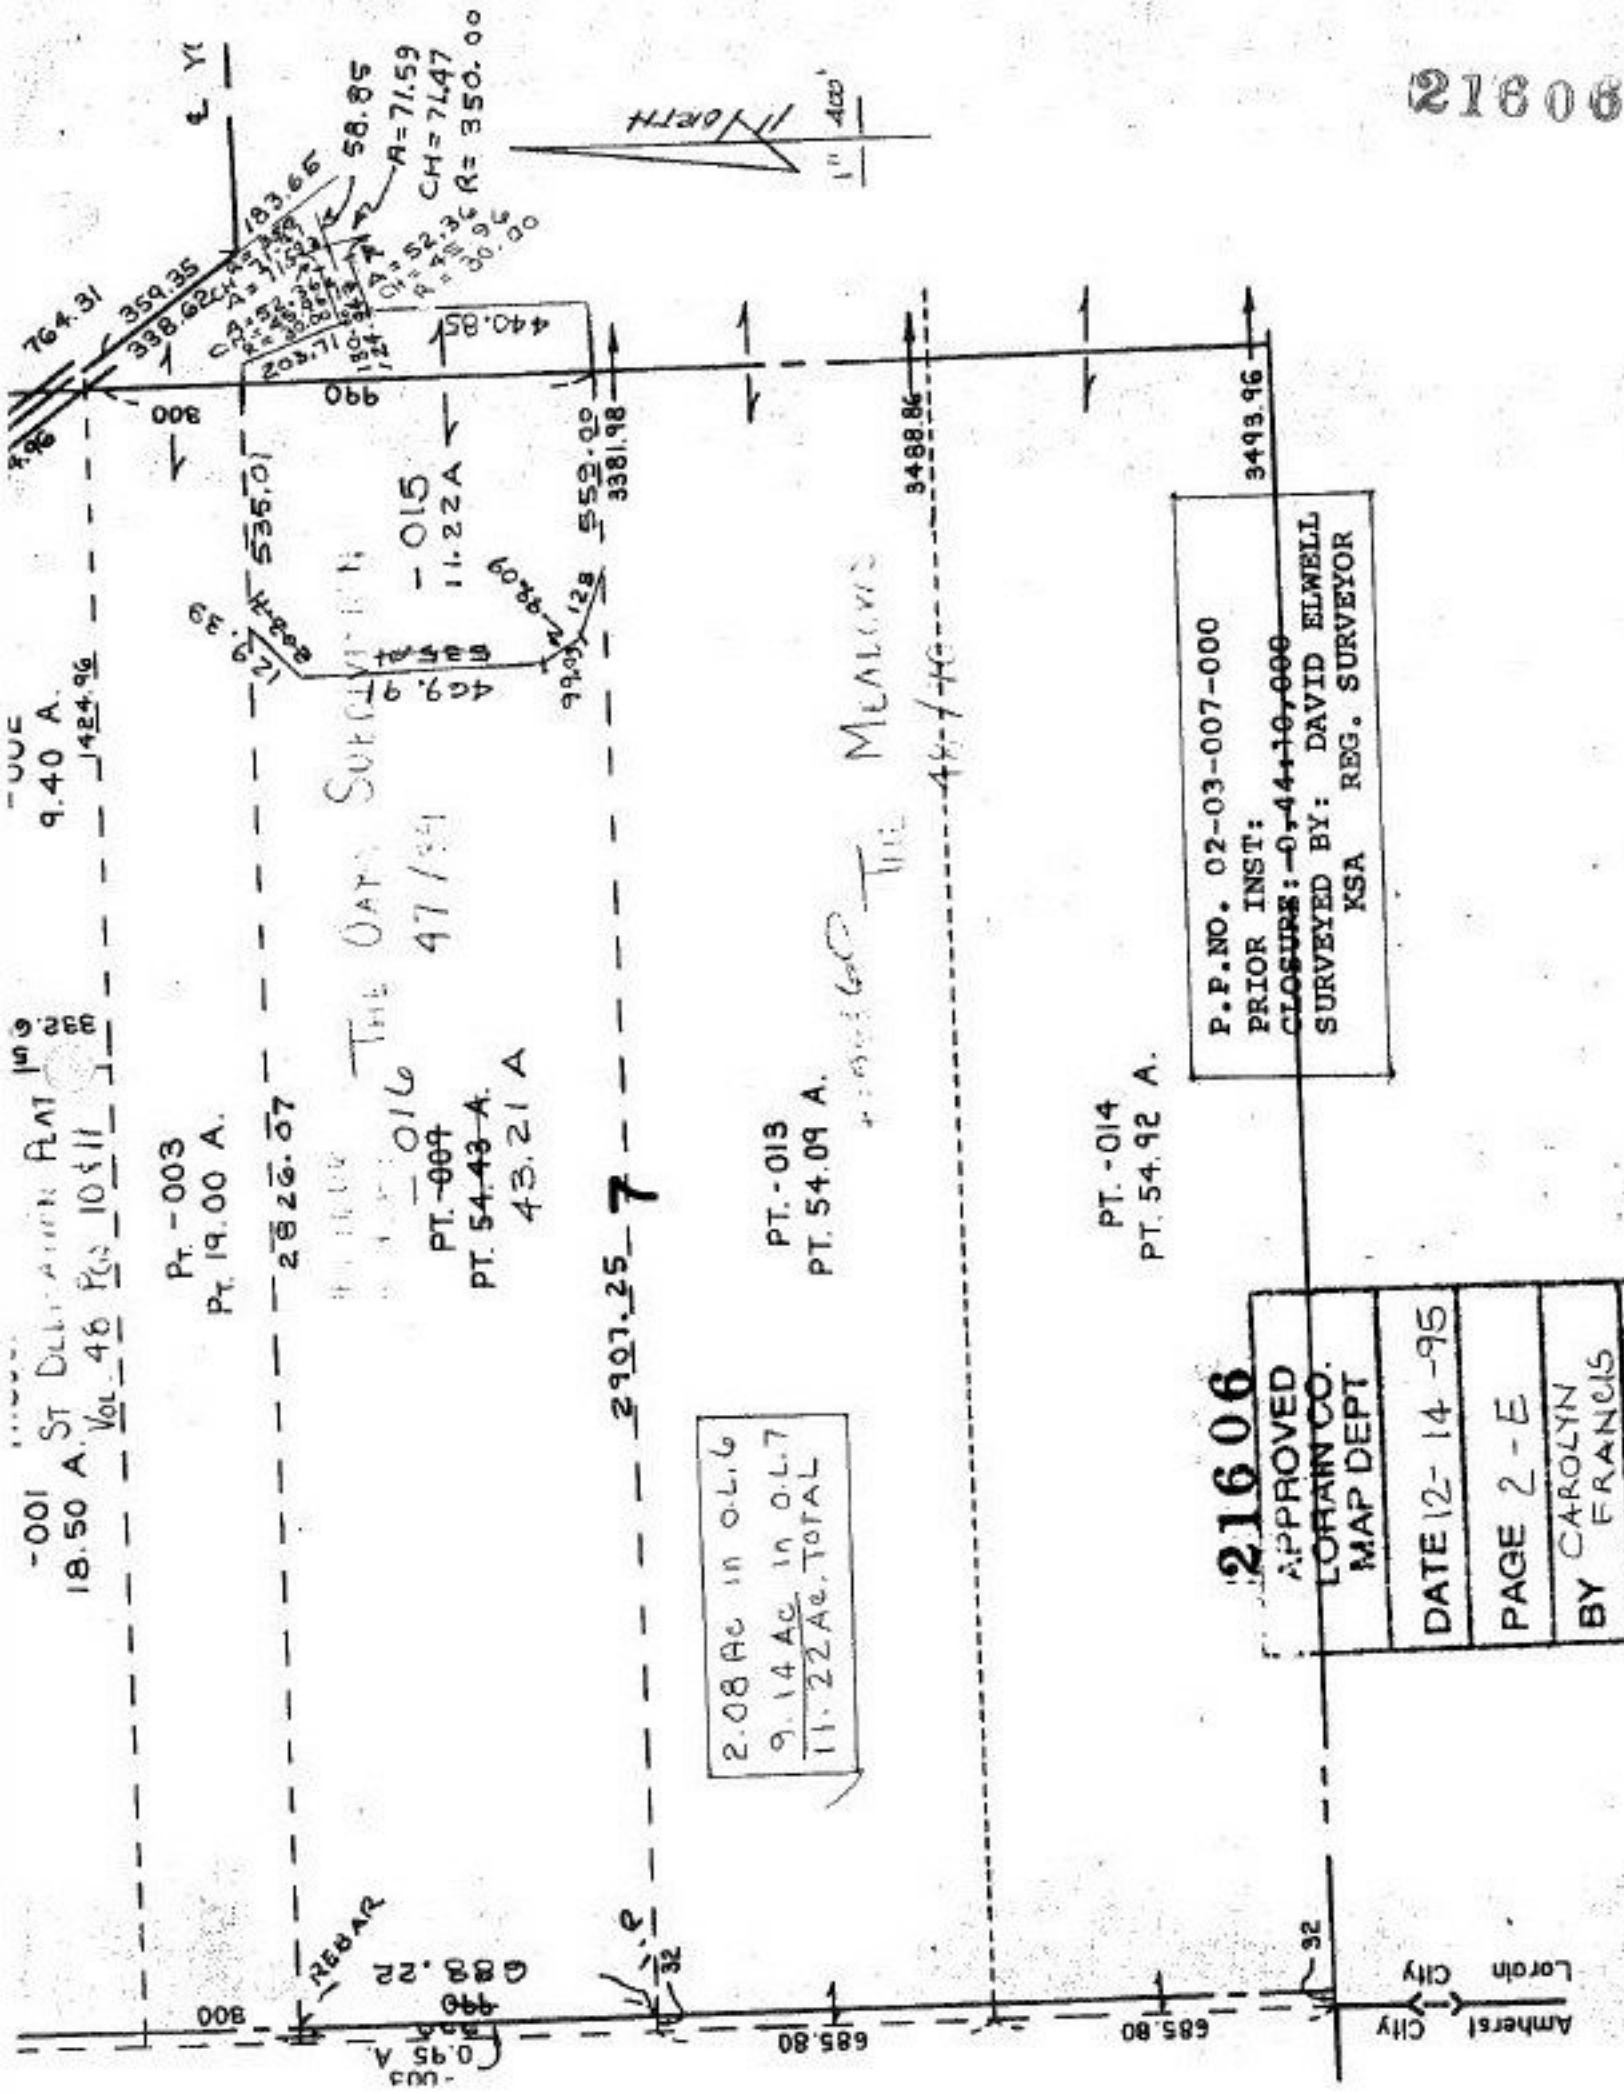

Pt. -003
Pt. 19.00 A.

2826.07

THE OATS SURVEY
PT. -016
47/99
PT. -007
PT. 54.43-A.
43.21 A

2907.25-7

2.08 Ac in O.L.G
9.14 Ac in O.L.7
11.22 Ac. TOTAL

PT. -013
PT. 54.09 A.

MEALONIS

PT. -014
PT. 54.92 A.

P.P. NO. 02-03-007-000
PRIOR INST:
CLOSURE: 0-44-10-000
SURVEYED BY: DAVID ELWELL
KSA REG. SURVEYOR

21606
APPROVED
LORAIN CO.
MAP DEPT
DATE 12-14-95
PAGE 2-E
BY CAROLYN FRANCIS
21606

Amherst City
Lorain City