

#21607

SEE SURVEY BY - E. HULTER # 7537

SPLIT # 4. RCM

Ⓐ 1200

Ⓑ 15000

PRIOR INST. REF. : DV 774/503


NEW PARCELS

05-00-024-104-011
R. 3/4 140

05-00-024-104-012

REMAINDER

SEE 5-00-023-B

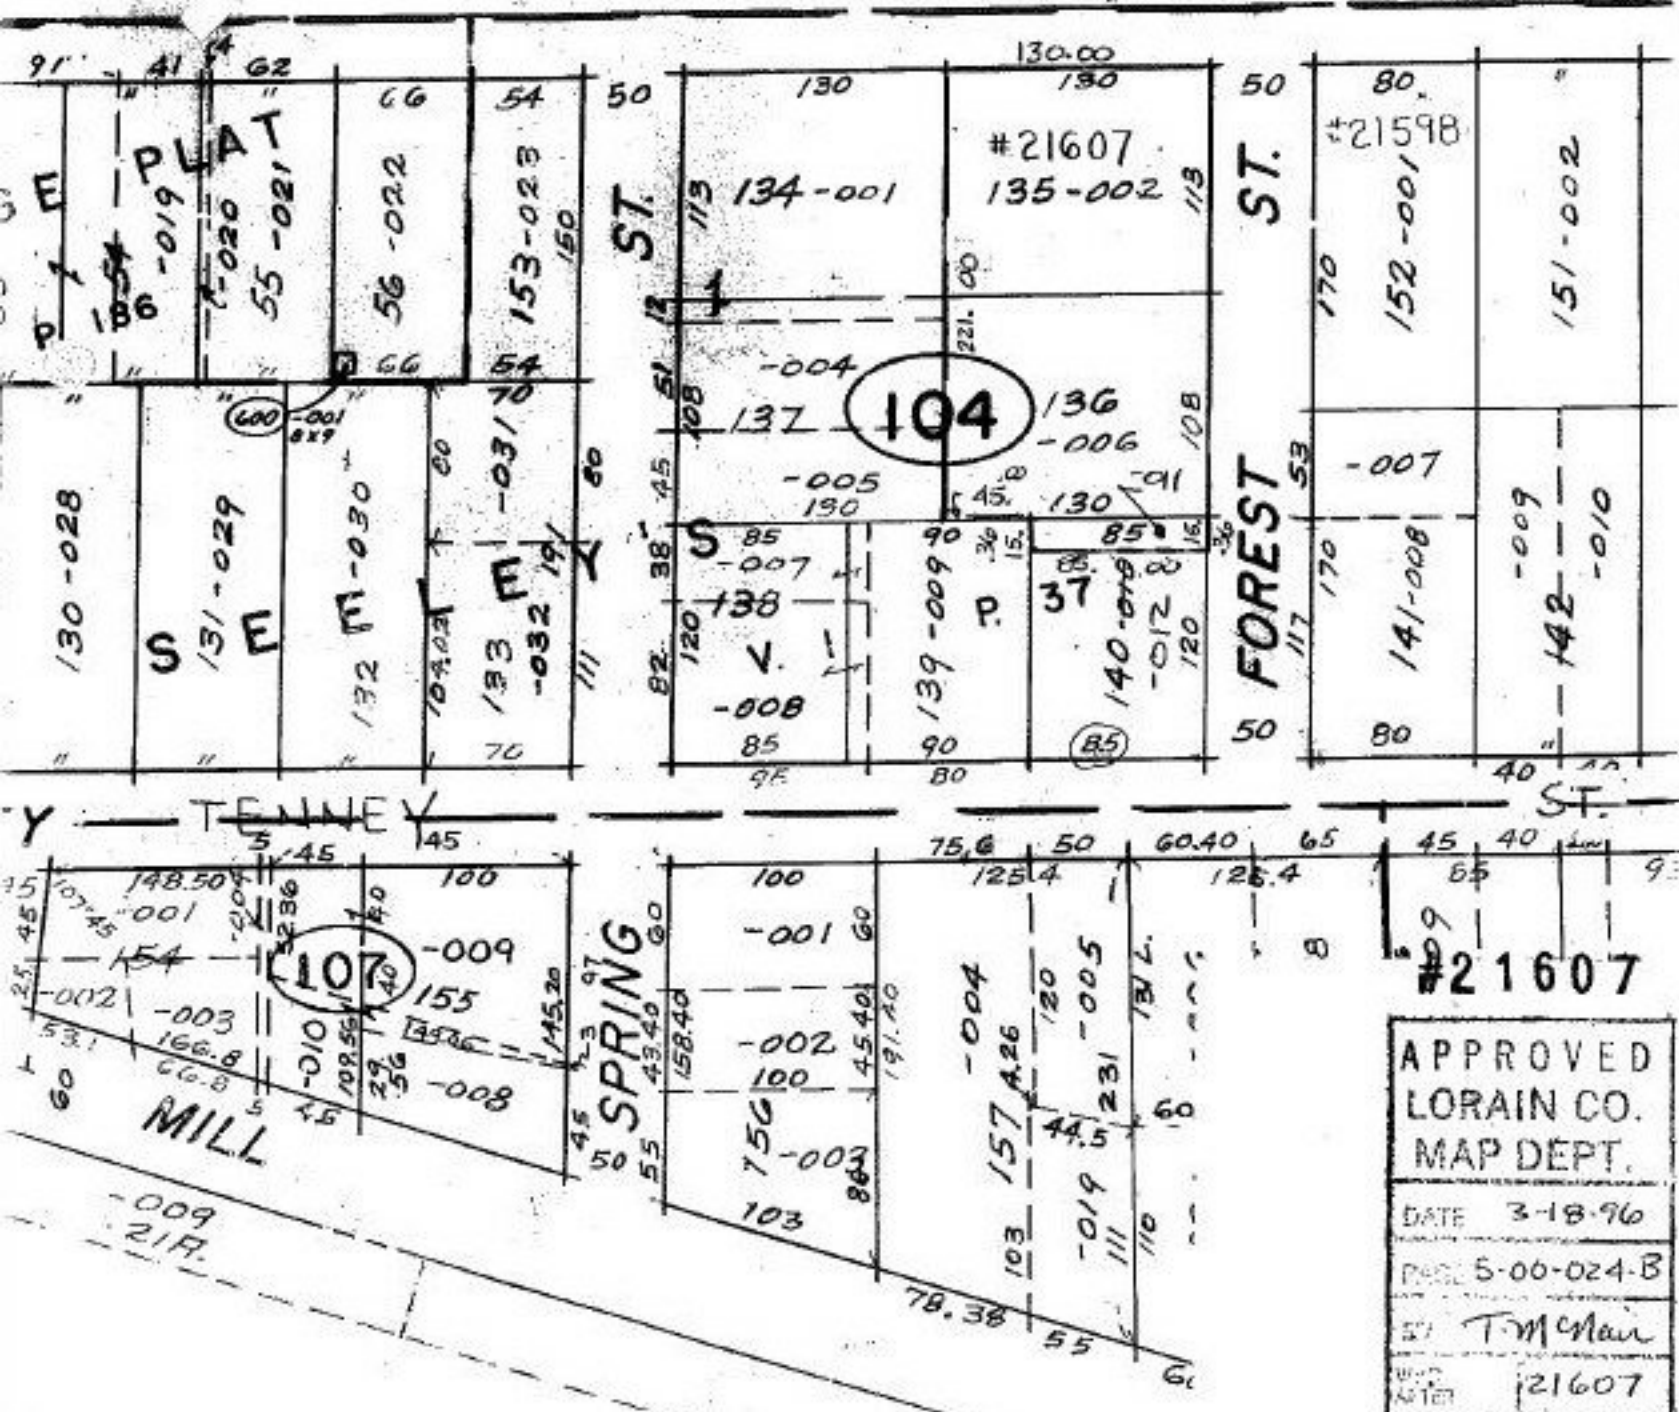

#21607

APPROVED
LORAIN CO.
MAP DEPT.

DATE 3-18-96

PAGE 5-00-024-B

BY T. McMan

WAS
AFTER 21607