


21632-X

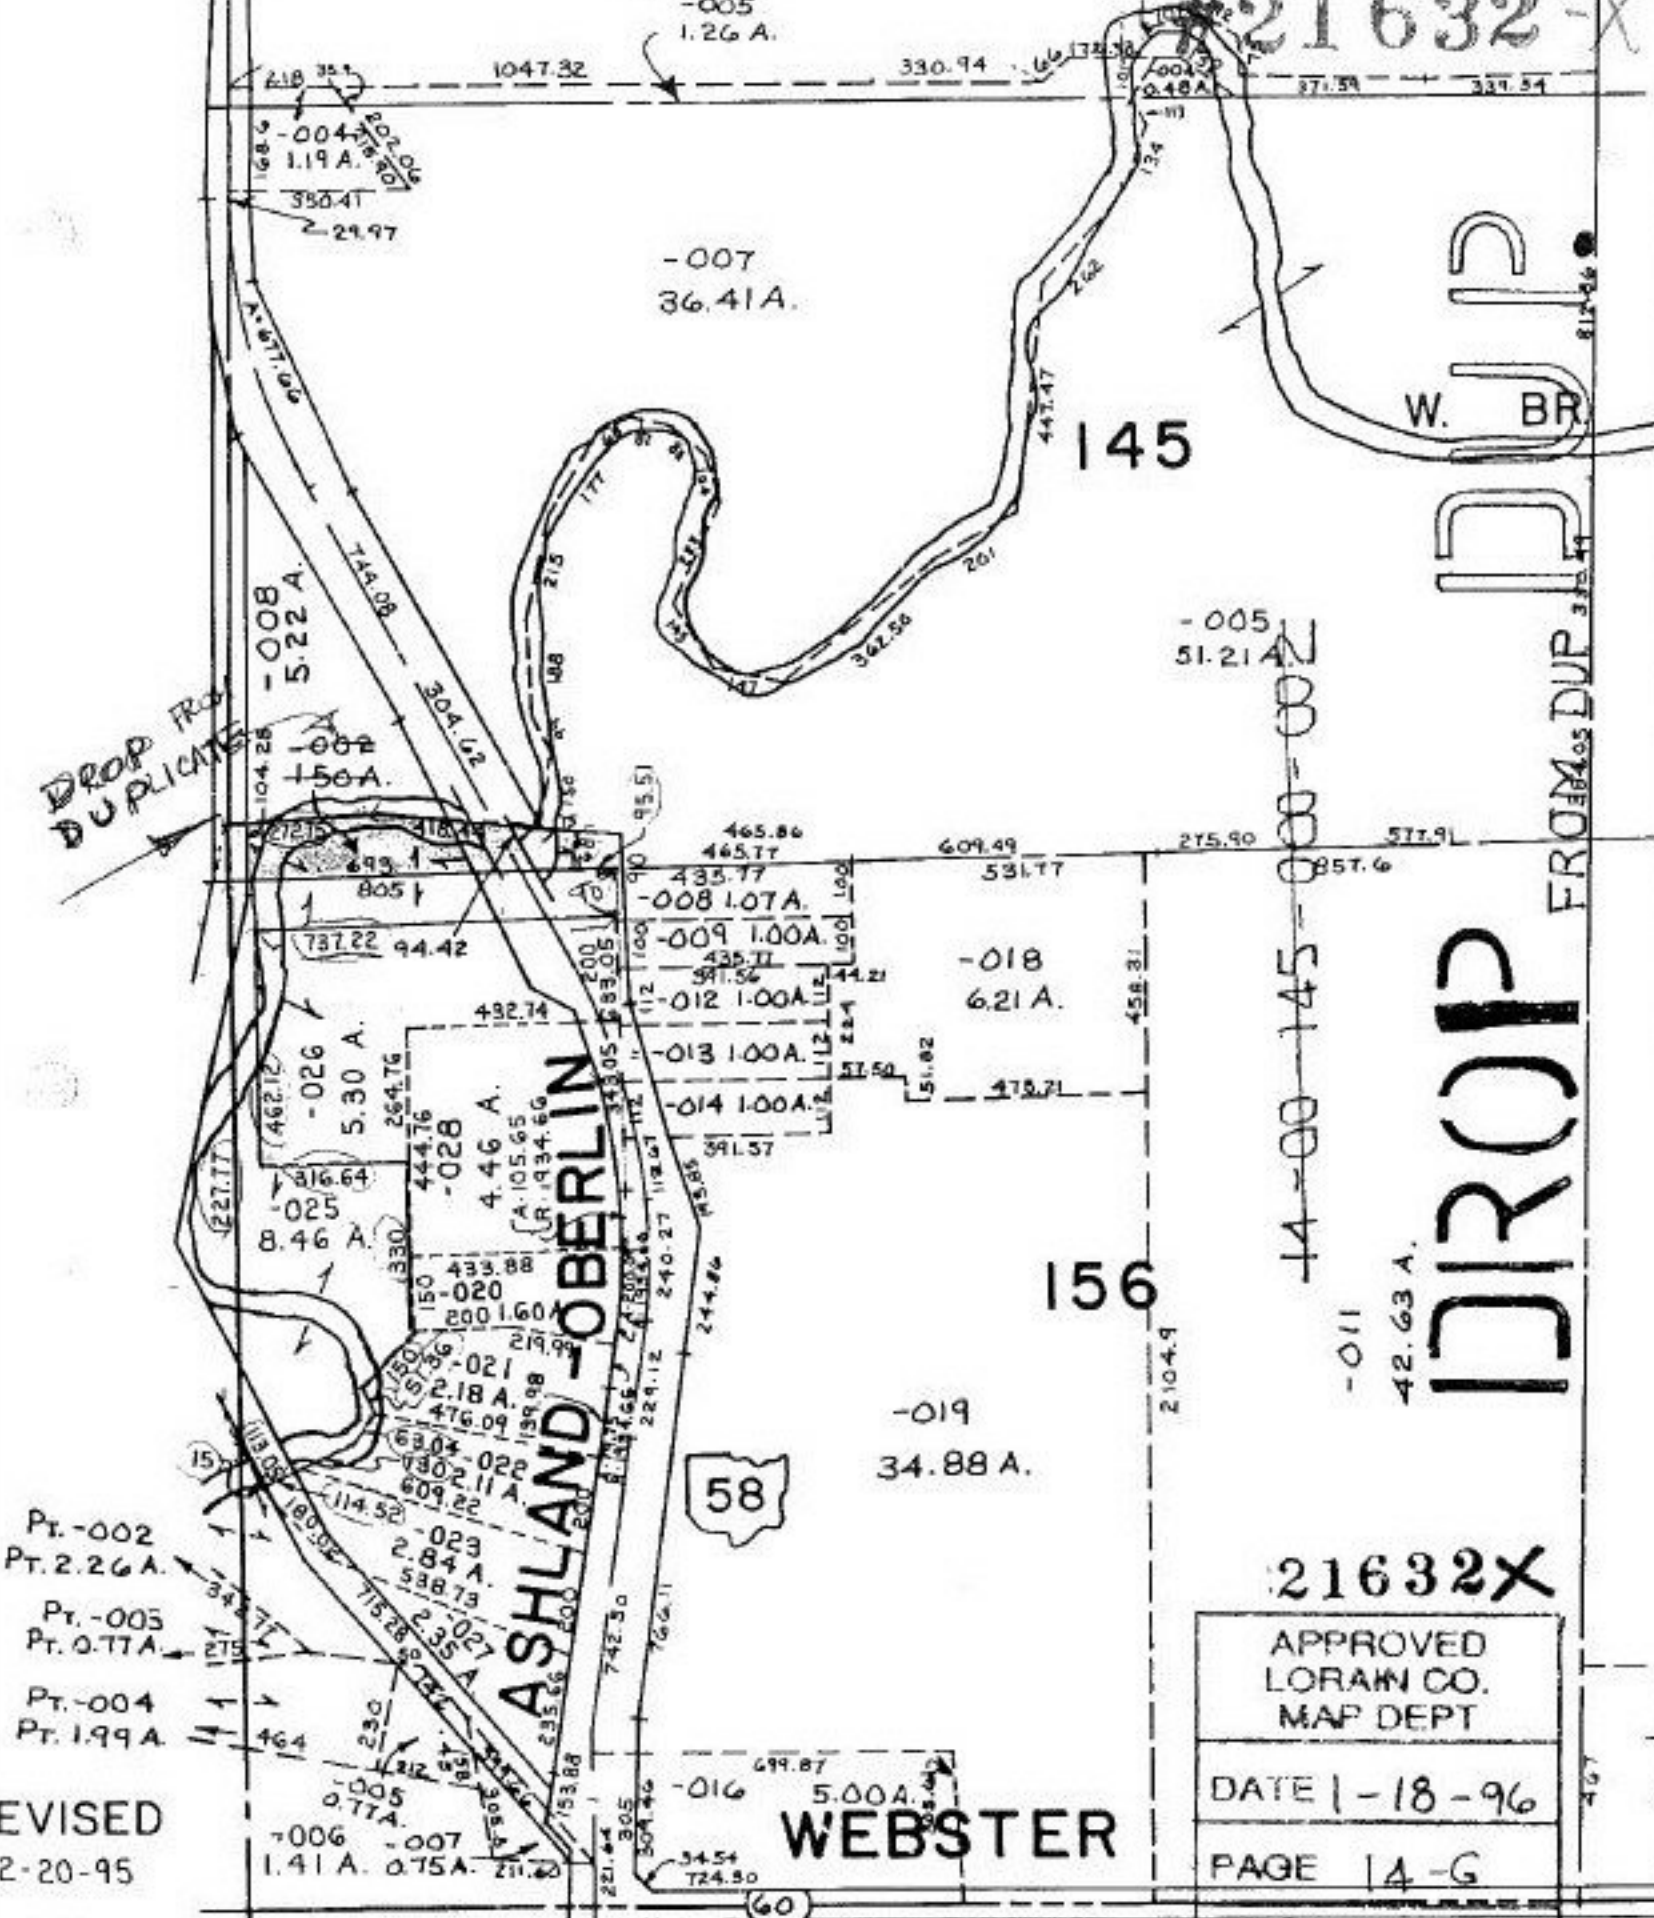

DROP FROM DUPLICATE

W. BR

DIRROP

FROM DUP

Pt. -002
Pt. 2.26 A.
Pt. -003
Pt. 0.77 A.
Pt. -004
Pt. 1.99 A.

REVISED 12-20-95

21632X

APPROVED LORAIN CO. MAP DEPT

DATE 1-18-96

PAGE 14-G

BY CAROLYN FRANCIS

PITTSFIELD TWP. 21632X

WEBSTER



156

145

-007
36.41 A.

-005
51.21 A.

-019
34.88 A.

-018
6.21 A.

-006
1.41 A.

-007
0.75 A.

-026
5.30 A.

-028
4.46 A.

-021
2.18 A.

-022
2.84 A.

-023
2.84 A.

-008
1.07 A.

-009
1.00 A.

-012
1.00 A.

-013
1.00 A.

-014
1.00 A.

-016
5.00 A.

-008
5.22 A.

-002
1.50 A.

-004
1.19 A.

-005
1.26 A.

-004
0.48 A.