

#21639


436.40

- 059
- ~~058~~

PT. ~~057~~
PT. ~~23.52 A.~~
17.55 A.
17.04 A

#21639
APPROVED LORAIN CO MAP DEPT 53.7
DATE 1-24-96
PAGE 10-00-015 G
BY CAROLYN FRANCIS
#21639

P.P. NO. 10-00-015-116
PRIOR INST.
O.R. 447/513

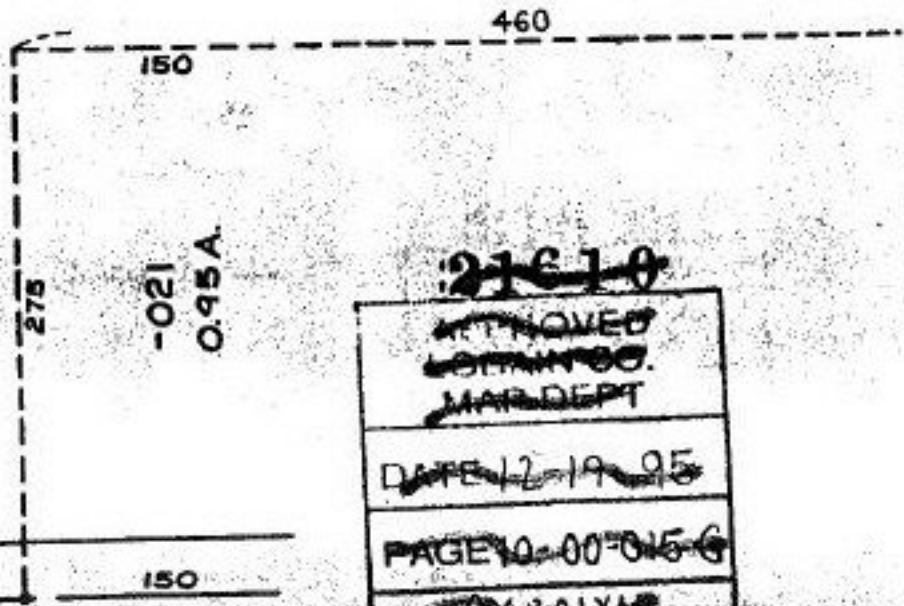

60
281.46
ROBSON

21610
APPROVED LORAIN CO. MAP DEPT
DATE 12-19-95
PAGE 10-00-015 G
BY CAROLYN FRANCIS
#21610

10-00-015-G