


#21647-D

DROP FROM DUP

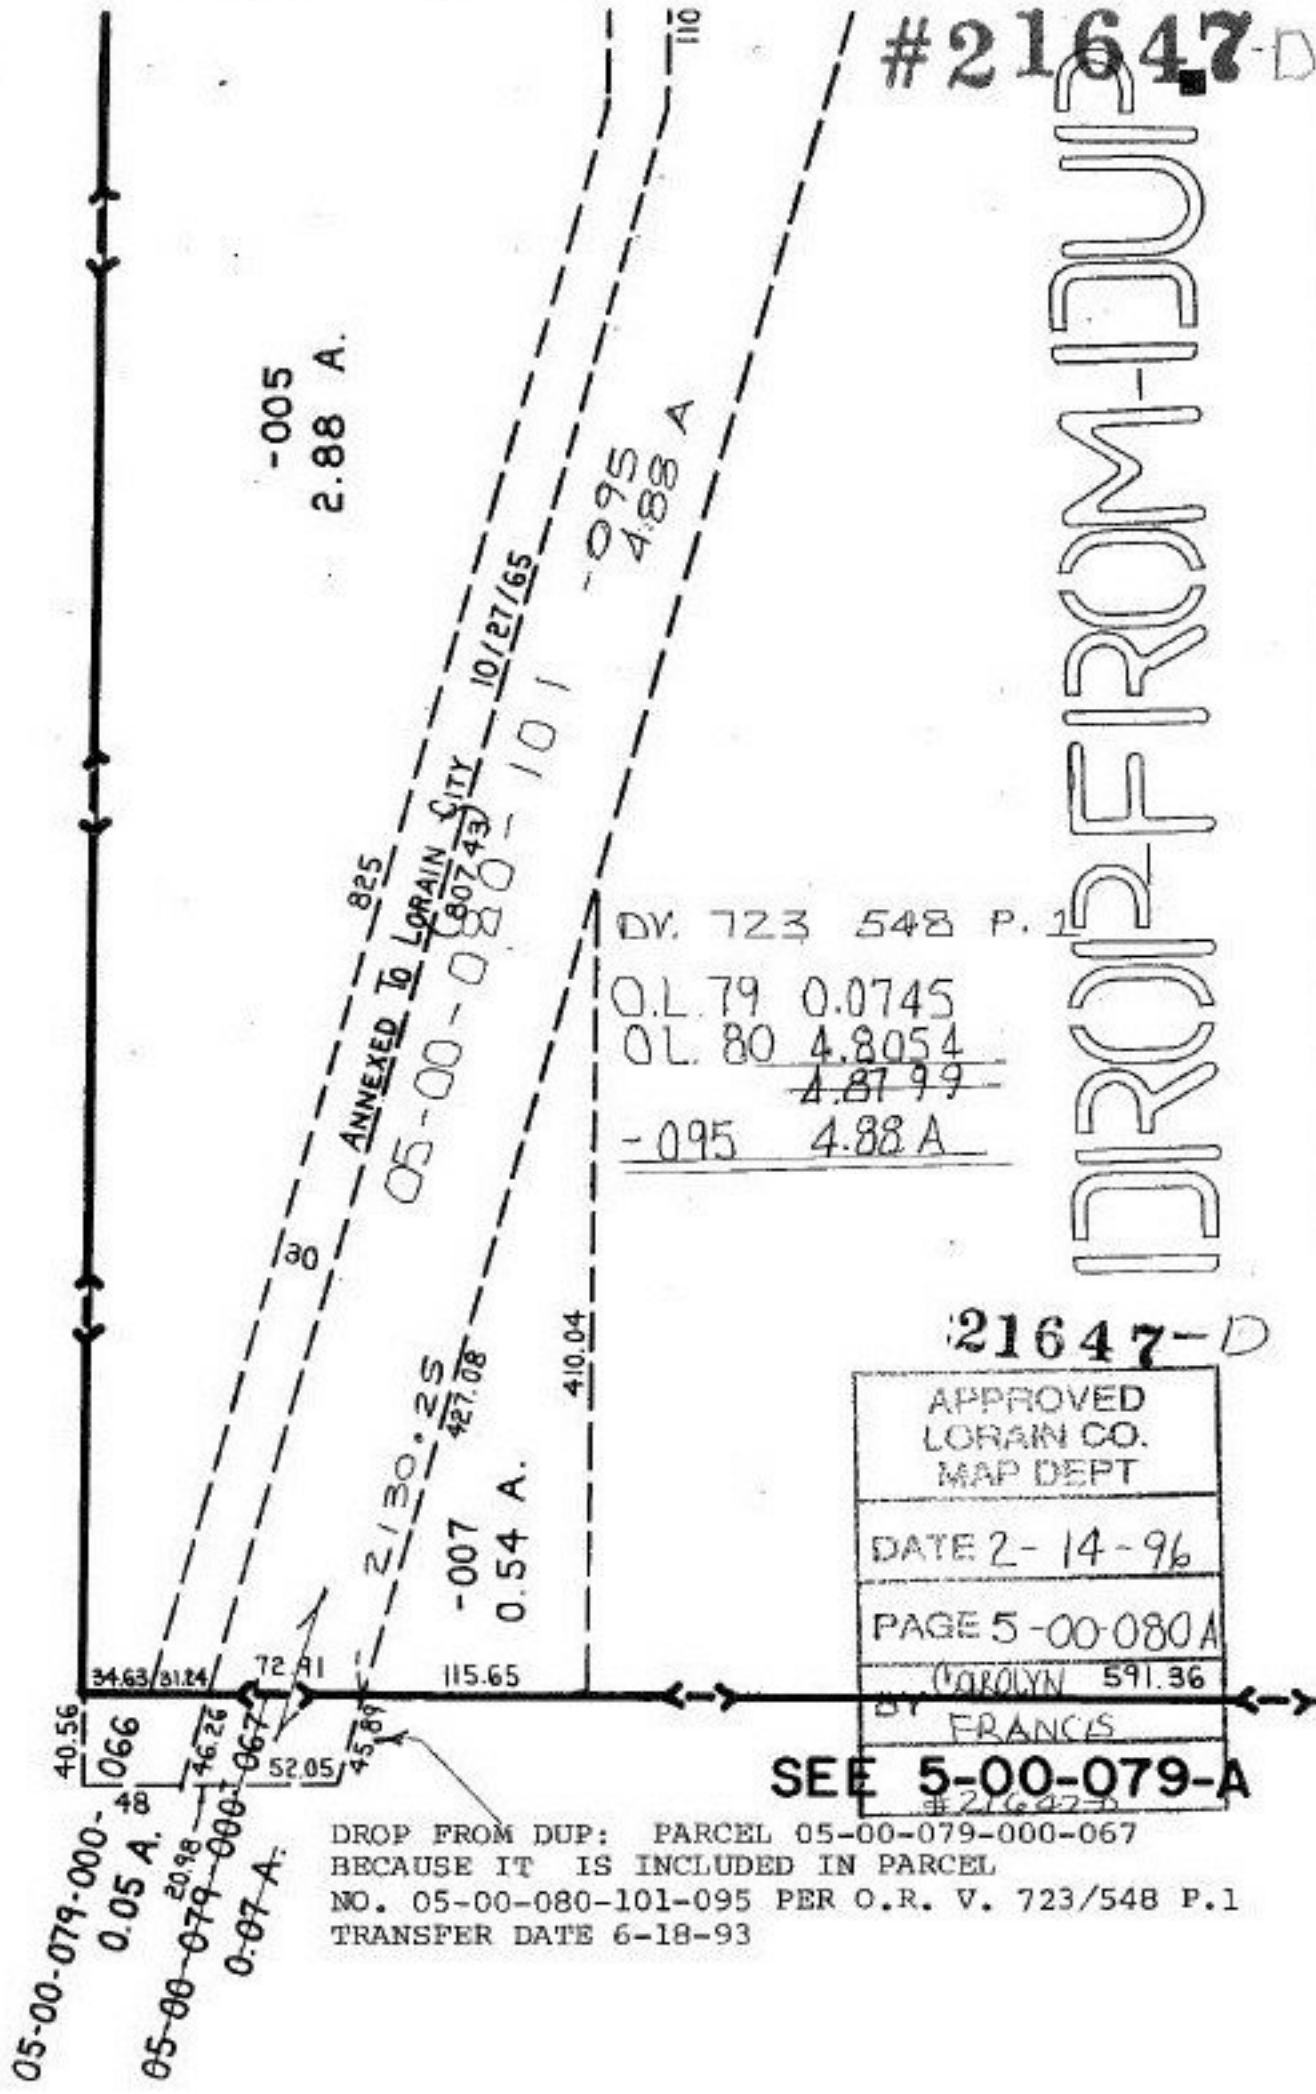

-005  
2.88 A.

-095  
4.88 A

ANNEXED TO LORAIN CITY (80743) 10/27/65

05-00-080-101

D.V. 723 548 P. 1

O.L. 79	0.0745
O.L. 80	4.8054
	<u>4.8799</u>
-095	<u>4.88 A</u>

21647-D

APPROVED LORAIN CO. MAP DEPT
DATE 2-14-96
PAGE 5-00-080A
CAROLYN 591.36
BY FRANCIS

SEE 5-00-079-A

DROP FROM DUP: PARCEL 05-00-079-000-067  
BECAUSE IT IS INCLUDED IN PARCEL  
NO. 05-00-080-101-095 PER O.R. V. 723/548 P.1  
TRANSFER DATE 6-18-93

05-00-079-000-066  
0.05 A.

05-00-079-000-067  
0.07 A.