


#21647-D

DROP FROM DUP.: PARCEL NO. 05-00-079-000-067
IT IS INCLUDED IN PARCEL NO. 05-00-080-101-095
PER O.R. 723/548 PARCEL 1 TRANSFER DATE 6-18-93

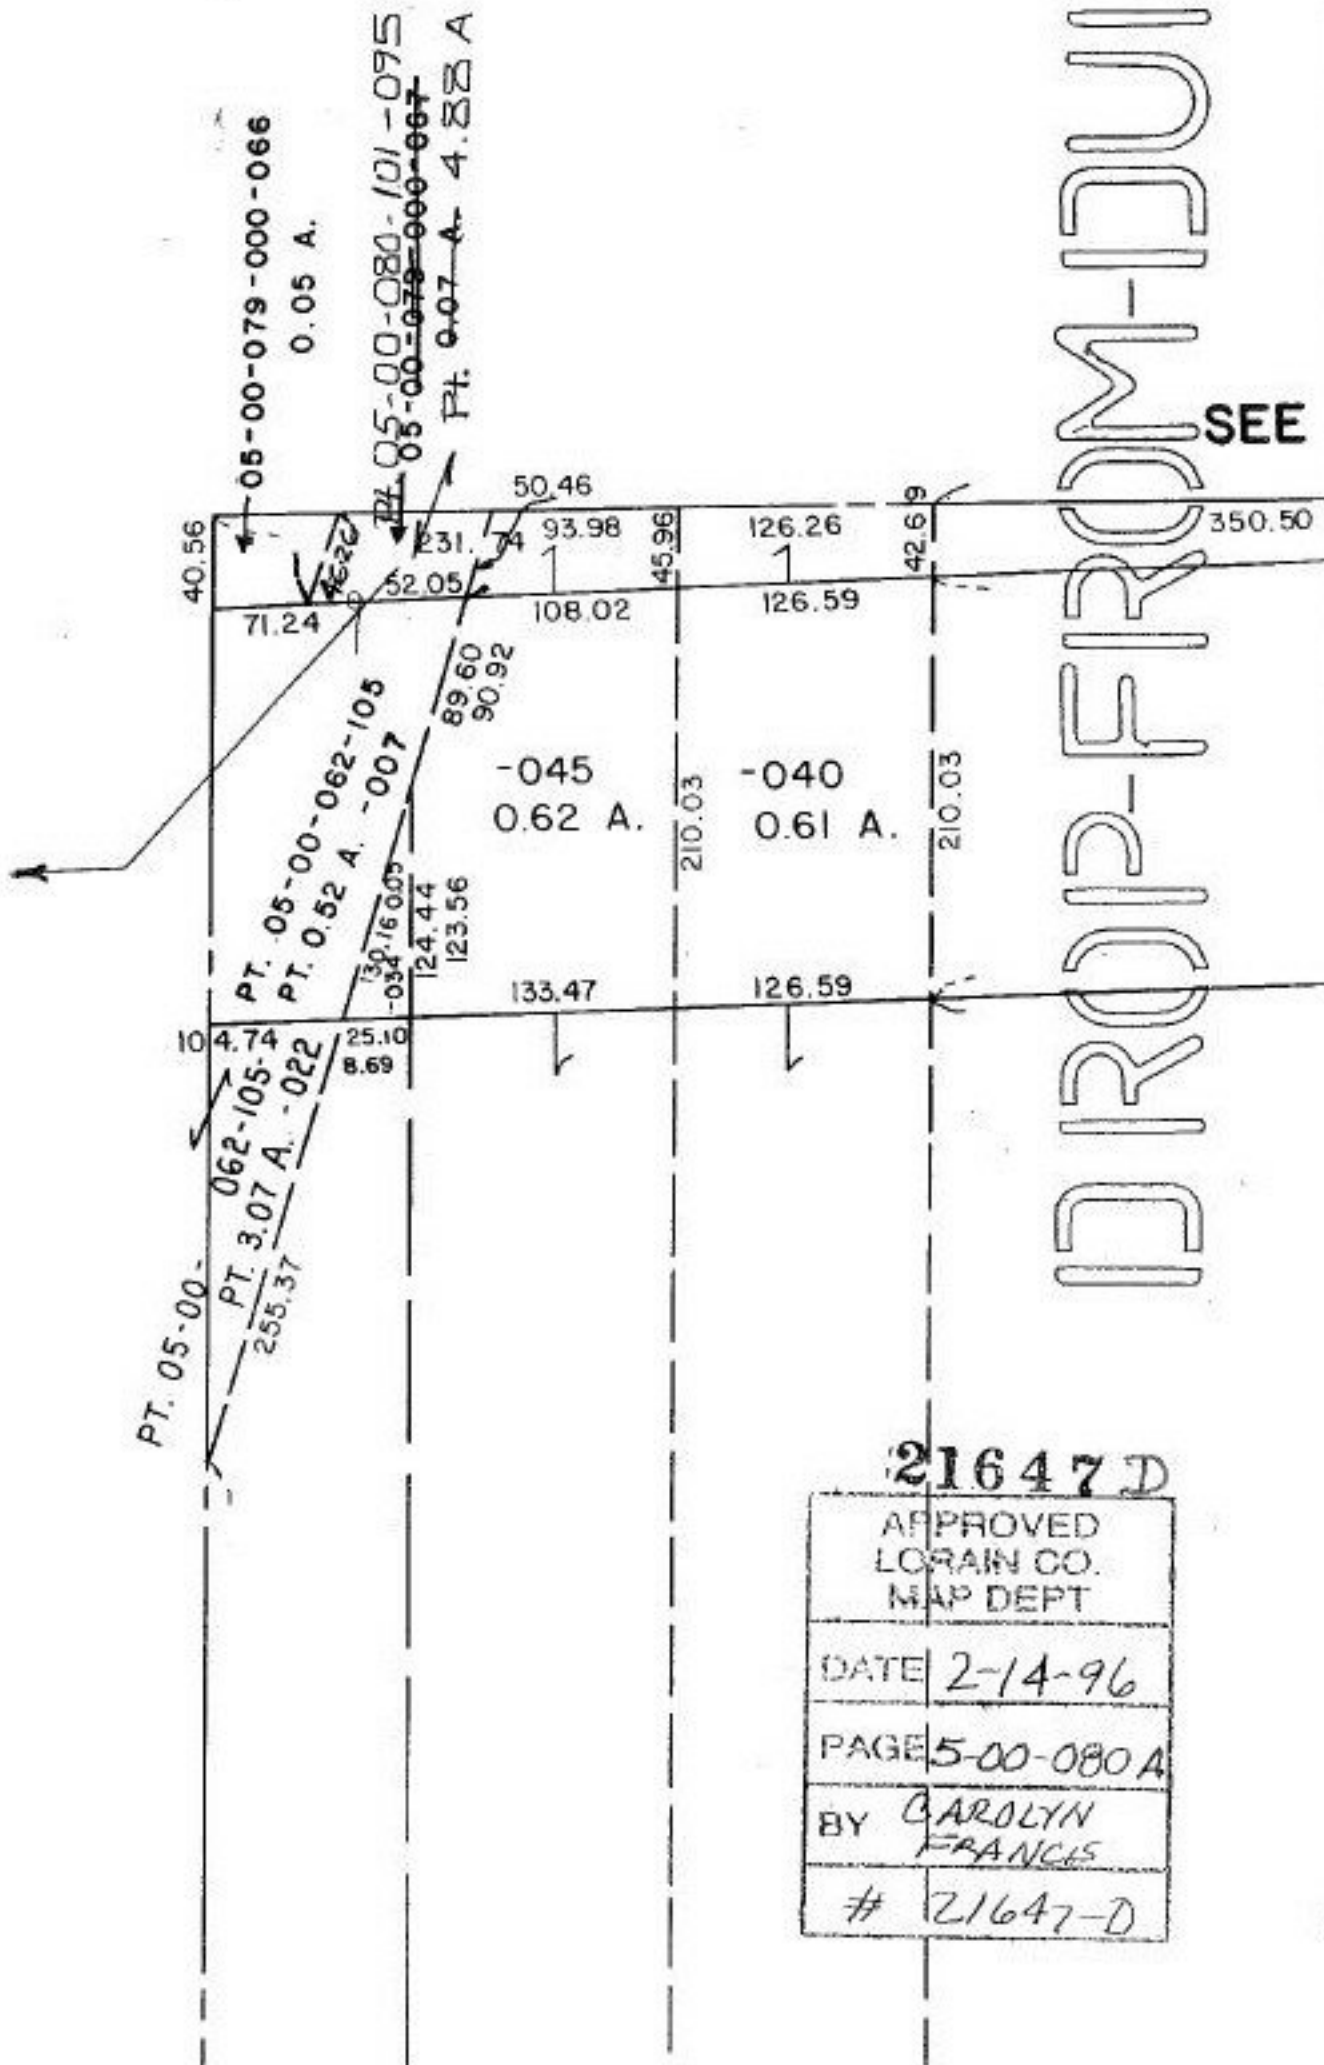

DROP FROM DUP. SEE

21647D

APPROVED LORAIN CO. MAP DEPT	
DATE	2-14-96
PAGE	5-00-080A
BY	CAROLYN FRANCES
#	21647-D