


#21647

P.P.NO. 17-06-026-000-  
PRIOR INST: O.R. 1185/126  
CLOSURE: 18.16ac. 0.02:10,000  
50.11ac. 1:INF.  
SURVEYED BY: RICHARD K. HUDNUT  
R.S.

APPROVED  
LORAIN CO.  
MAP DEPT  
DATE 1-29-96  
PAGE 17-H  
BY CAROLYN  
FRANCIS  
#21647

ANDERSON

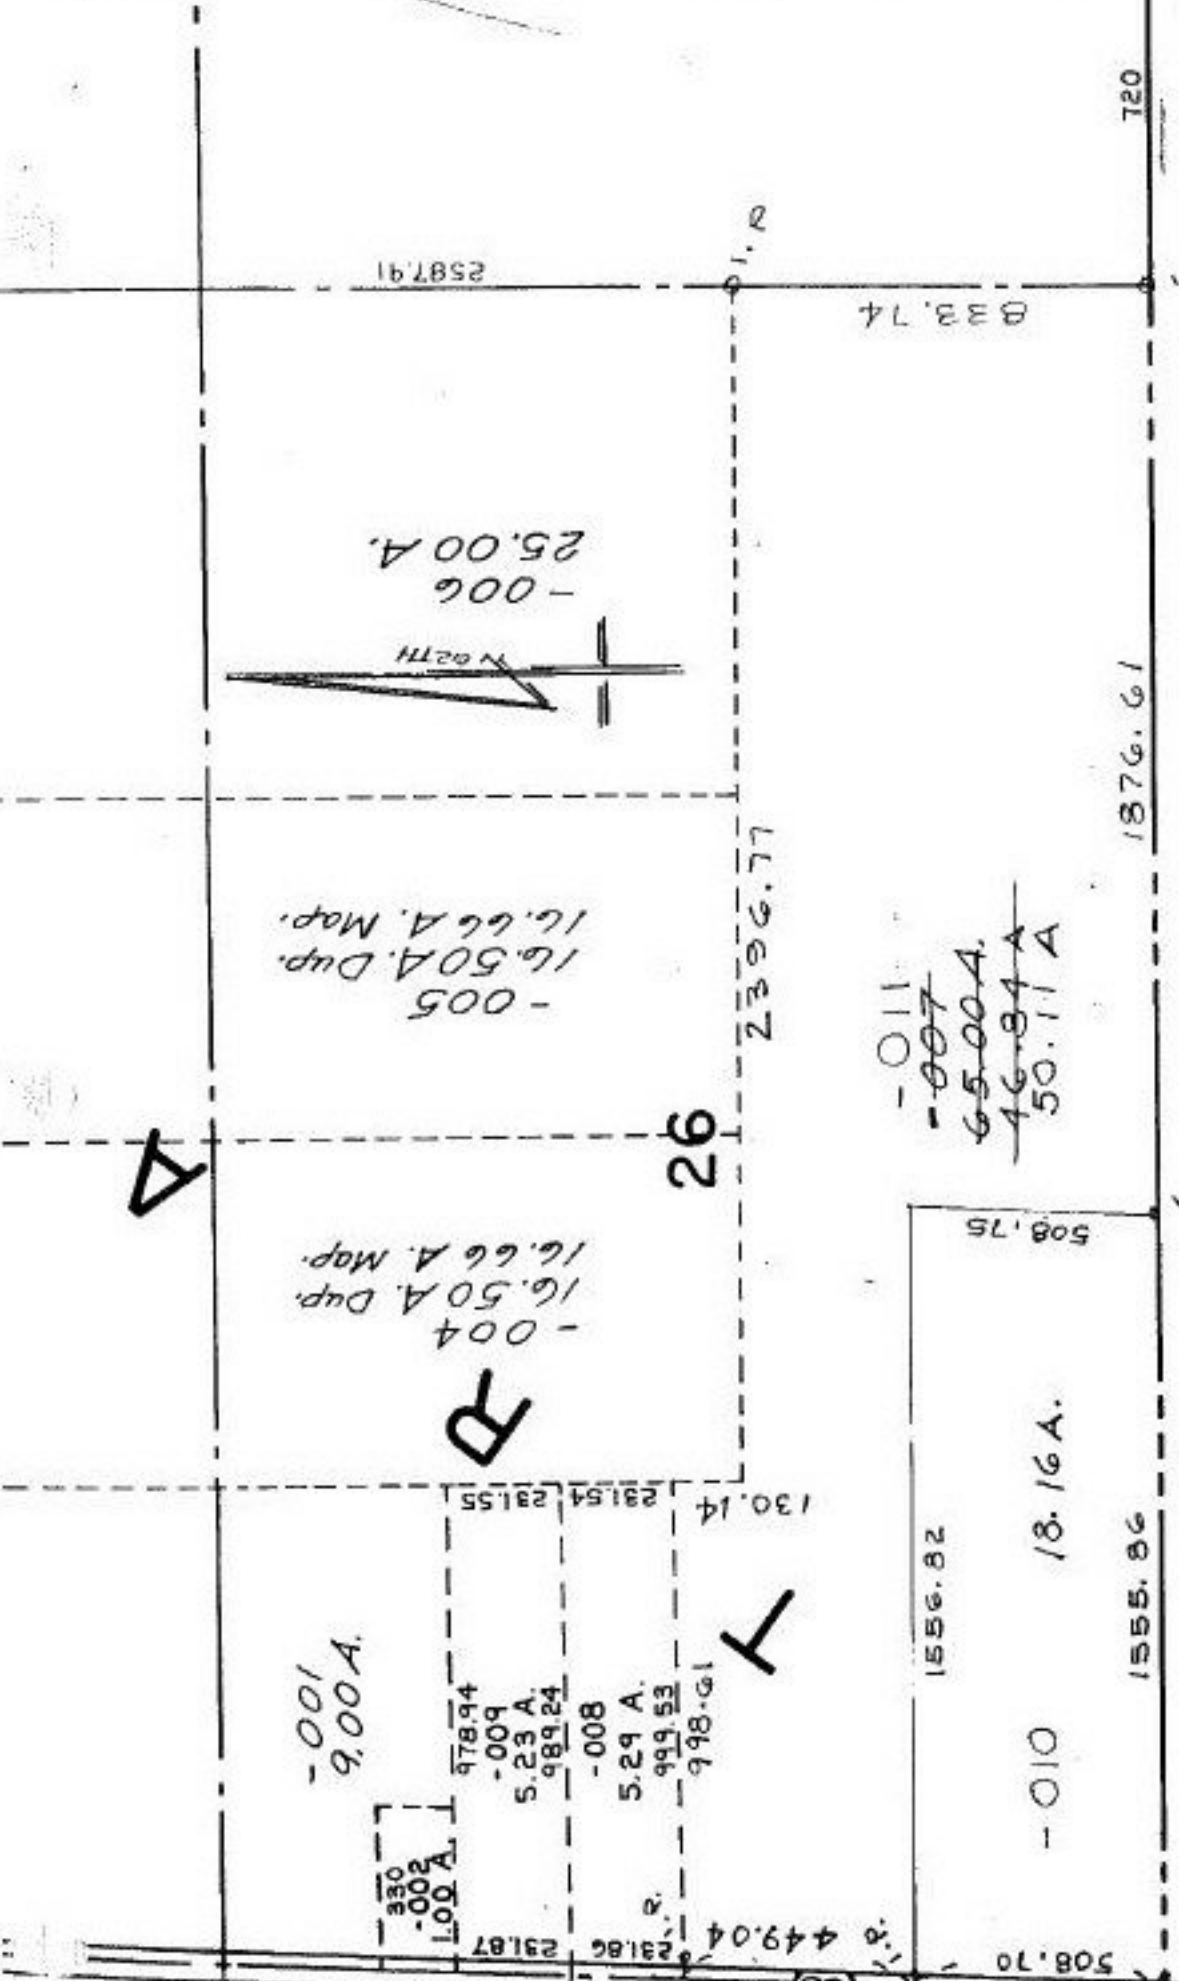

21647