


#21653

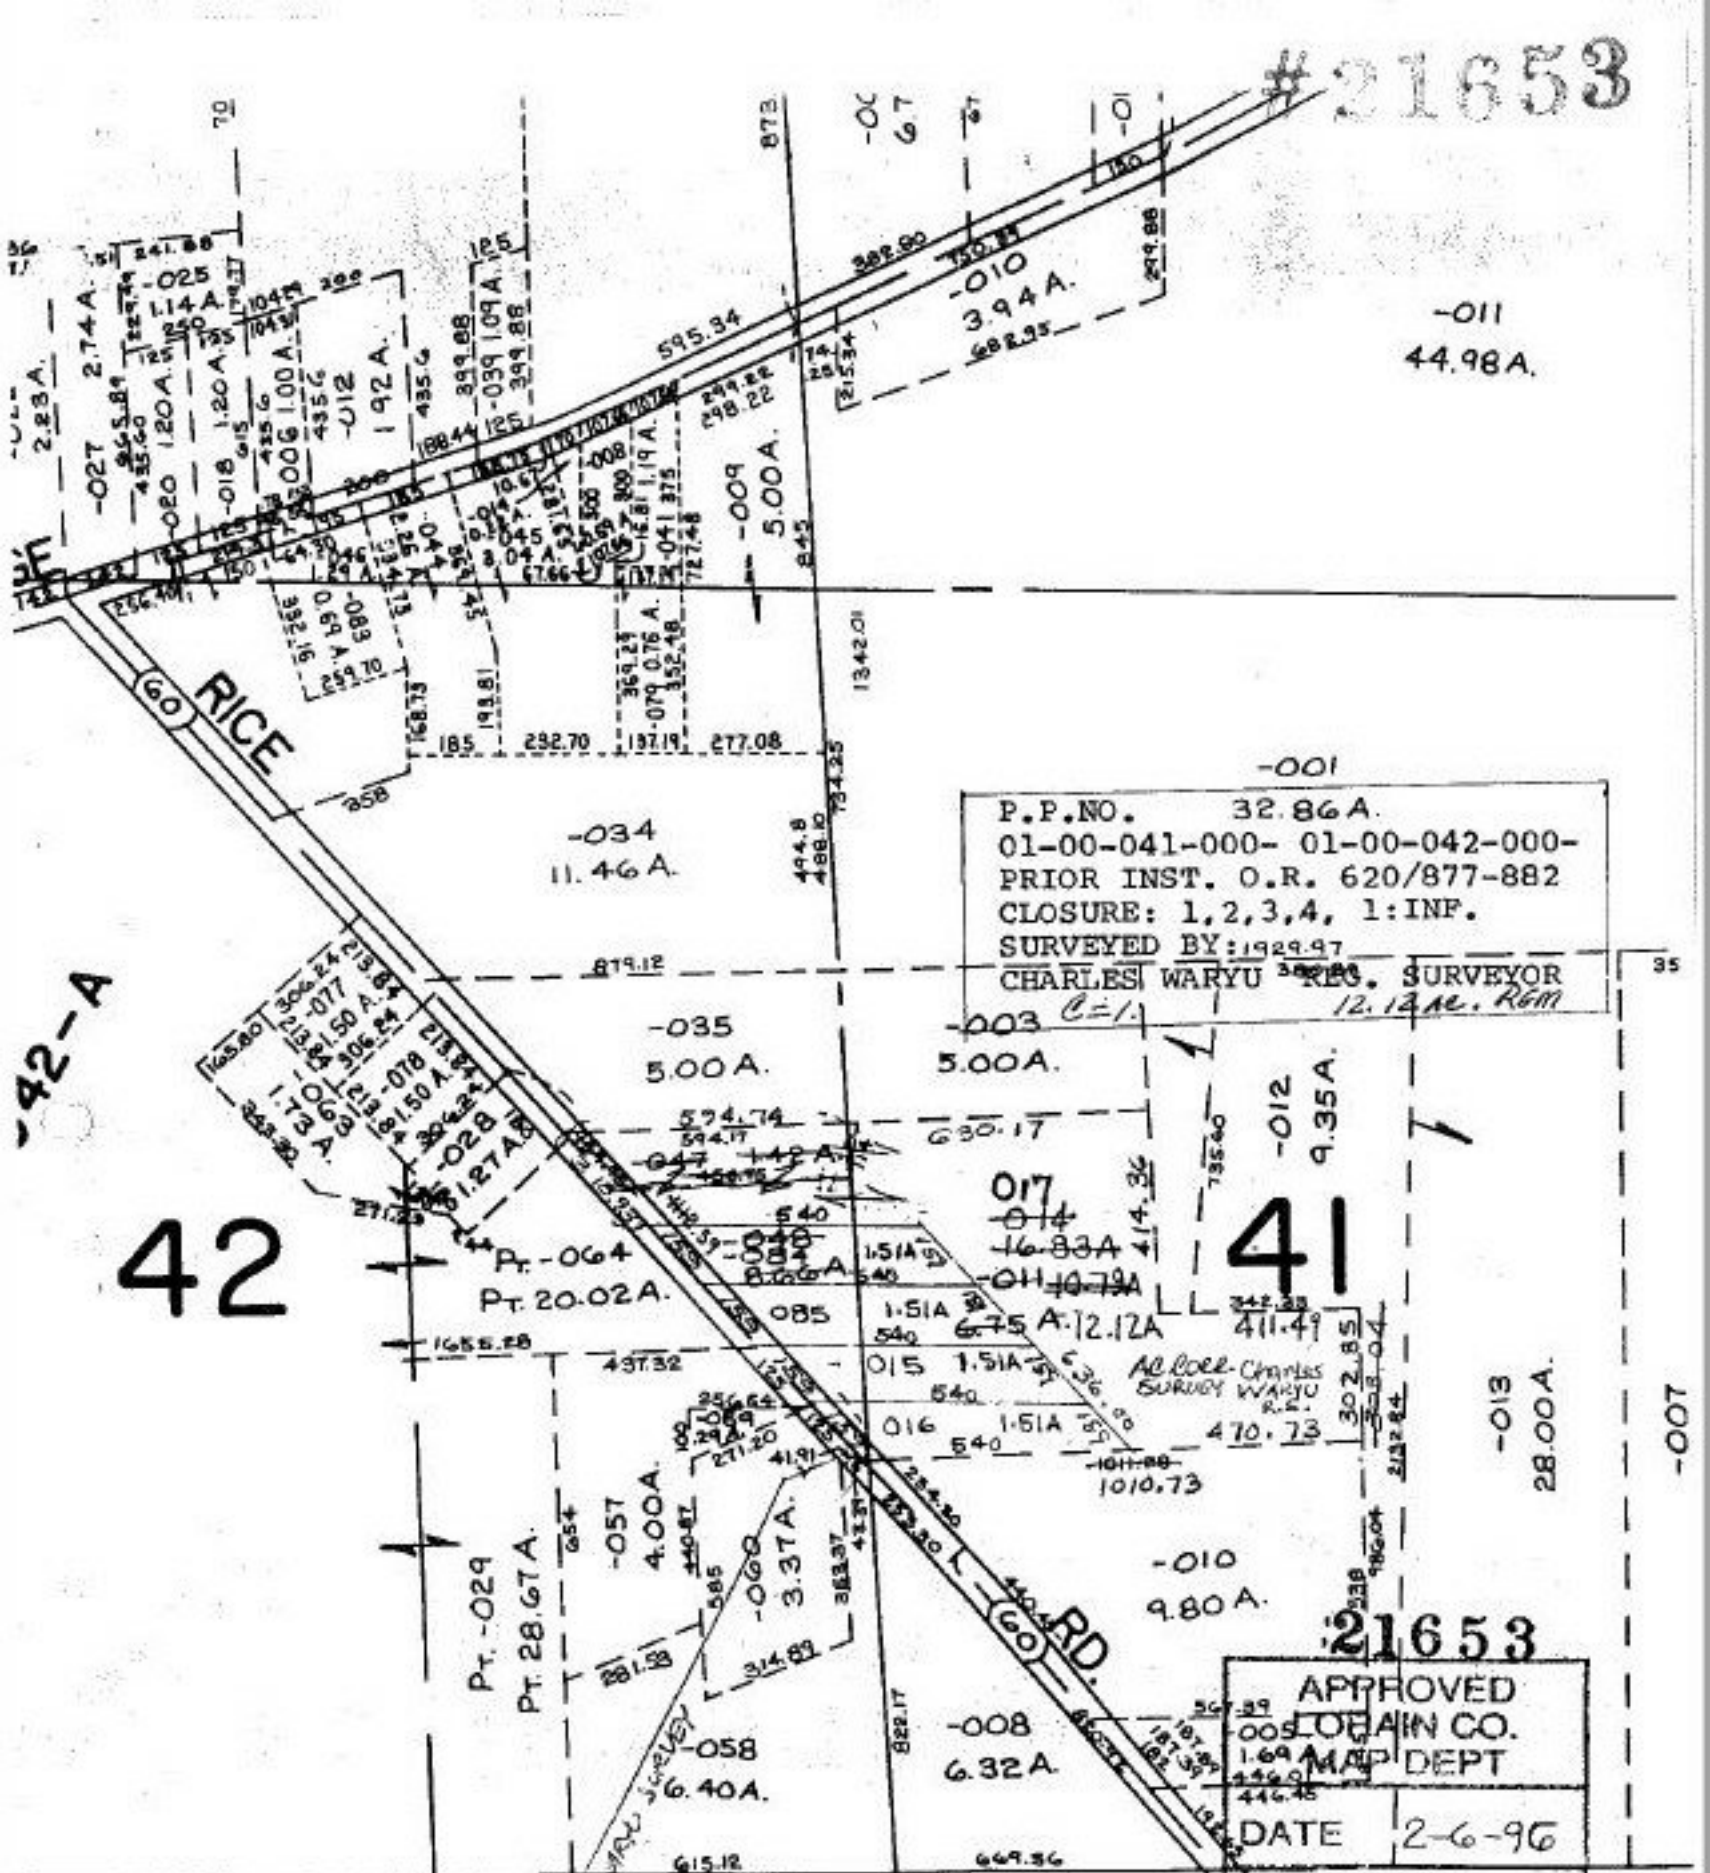

-001

P.P.NO. 32.86 A.
 01-00-041-000- 01-00-042-000-
 PRIOR INST. O.R. 620/877-882
 CLOSURE: 1,2,3,4, 1:INF.
 SURVEYED BY: 1929.97
 CHARLES WARYU REG. SURVEYOR
 12.12 A.M. RGM

-012 9.35 A.

41

-013 28.00 A.

-007

21653

APPROVED
 LOHAIN CO.
 MAP DEPT

DATE 2-6-96

PAGE 1-H

BY CAROLYN FRANCIS

21653



SEE I-L