


#21661

BROWNHELM STATION

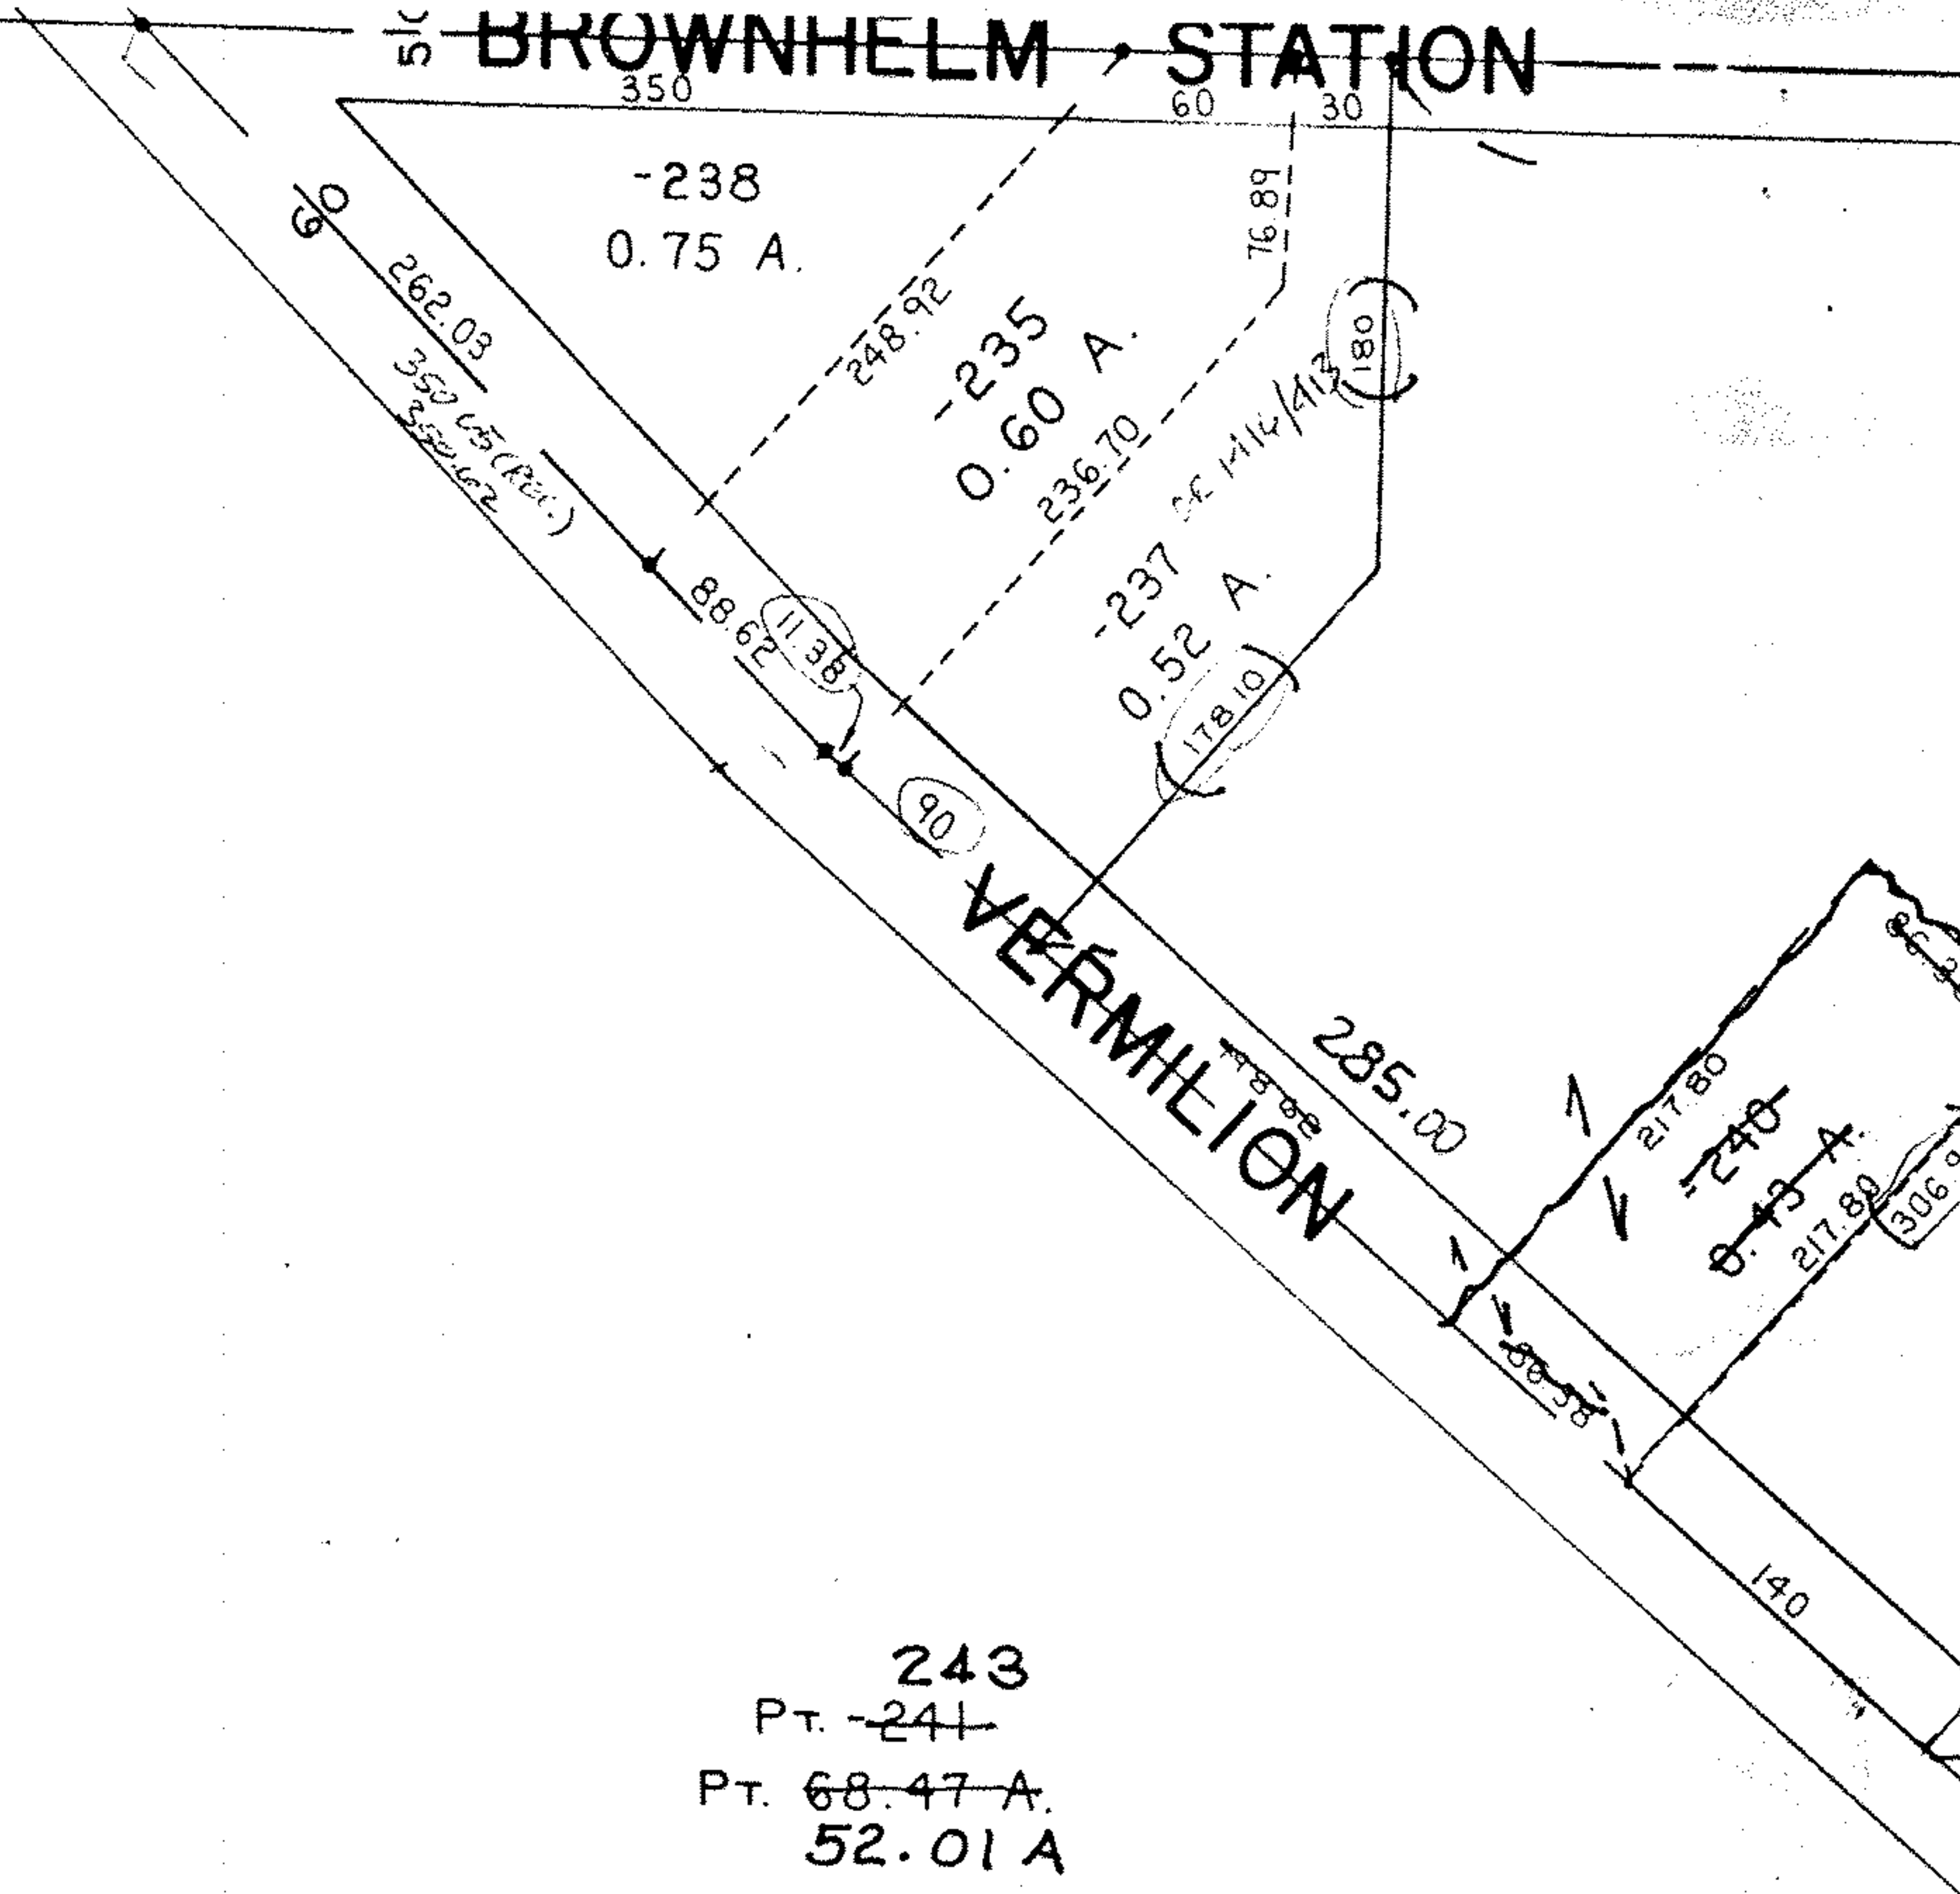

243
 Pt. ~~241~~
 Pt. 68.47 A.
 52.01 A

21661

APPROVED LORAIN CO. MAP DEPT
DATE 2-6-96
PAGE 1-00-017 B
BY CAROLYN FRANCIS
21661

DA
PA
BY

-216
 10.17 A.

310