


BEGINNING AT INTERSECTION OF CENTERLINE OF MIDDLE RIDGE ROAD AND WESTERLY BOUND

O.L. 6 thence 1373.35 ft. to angle point thences:

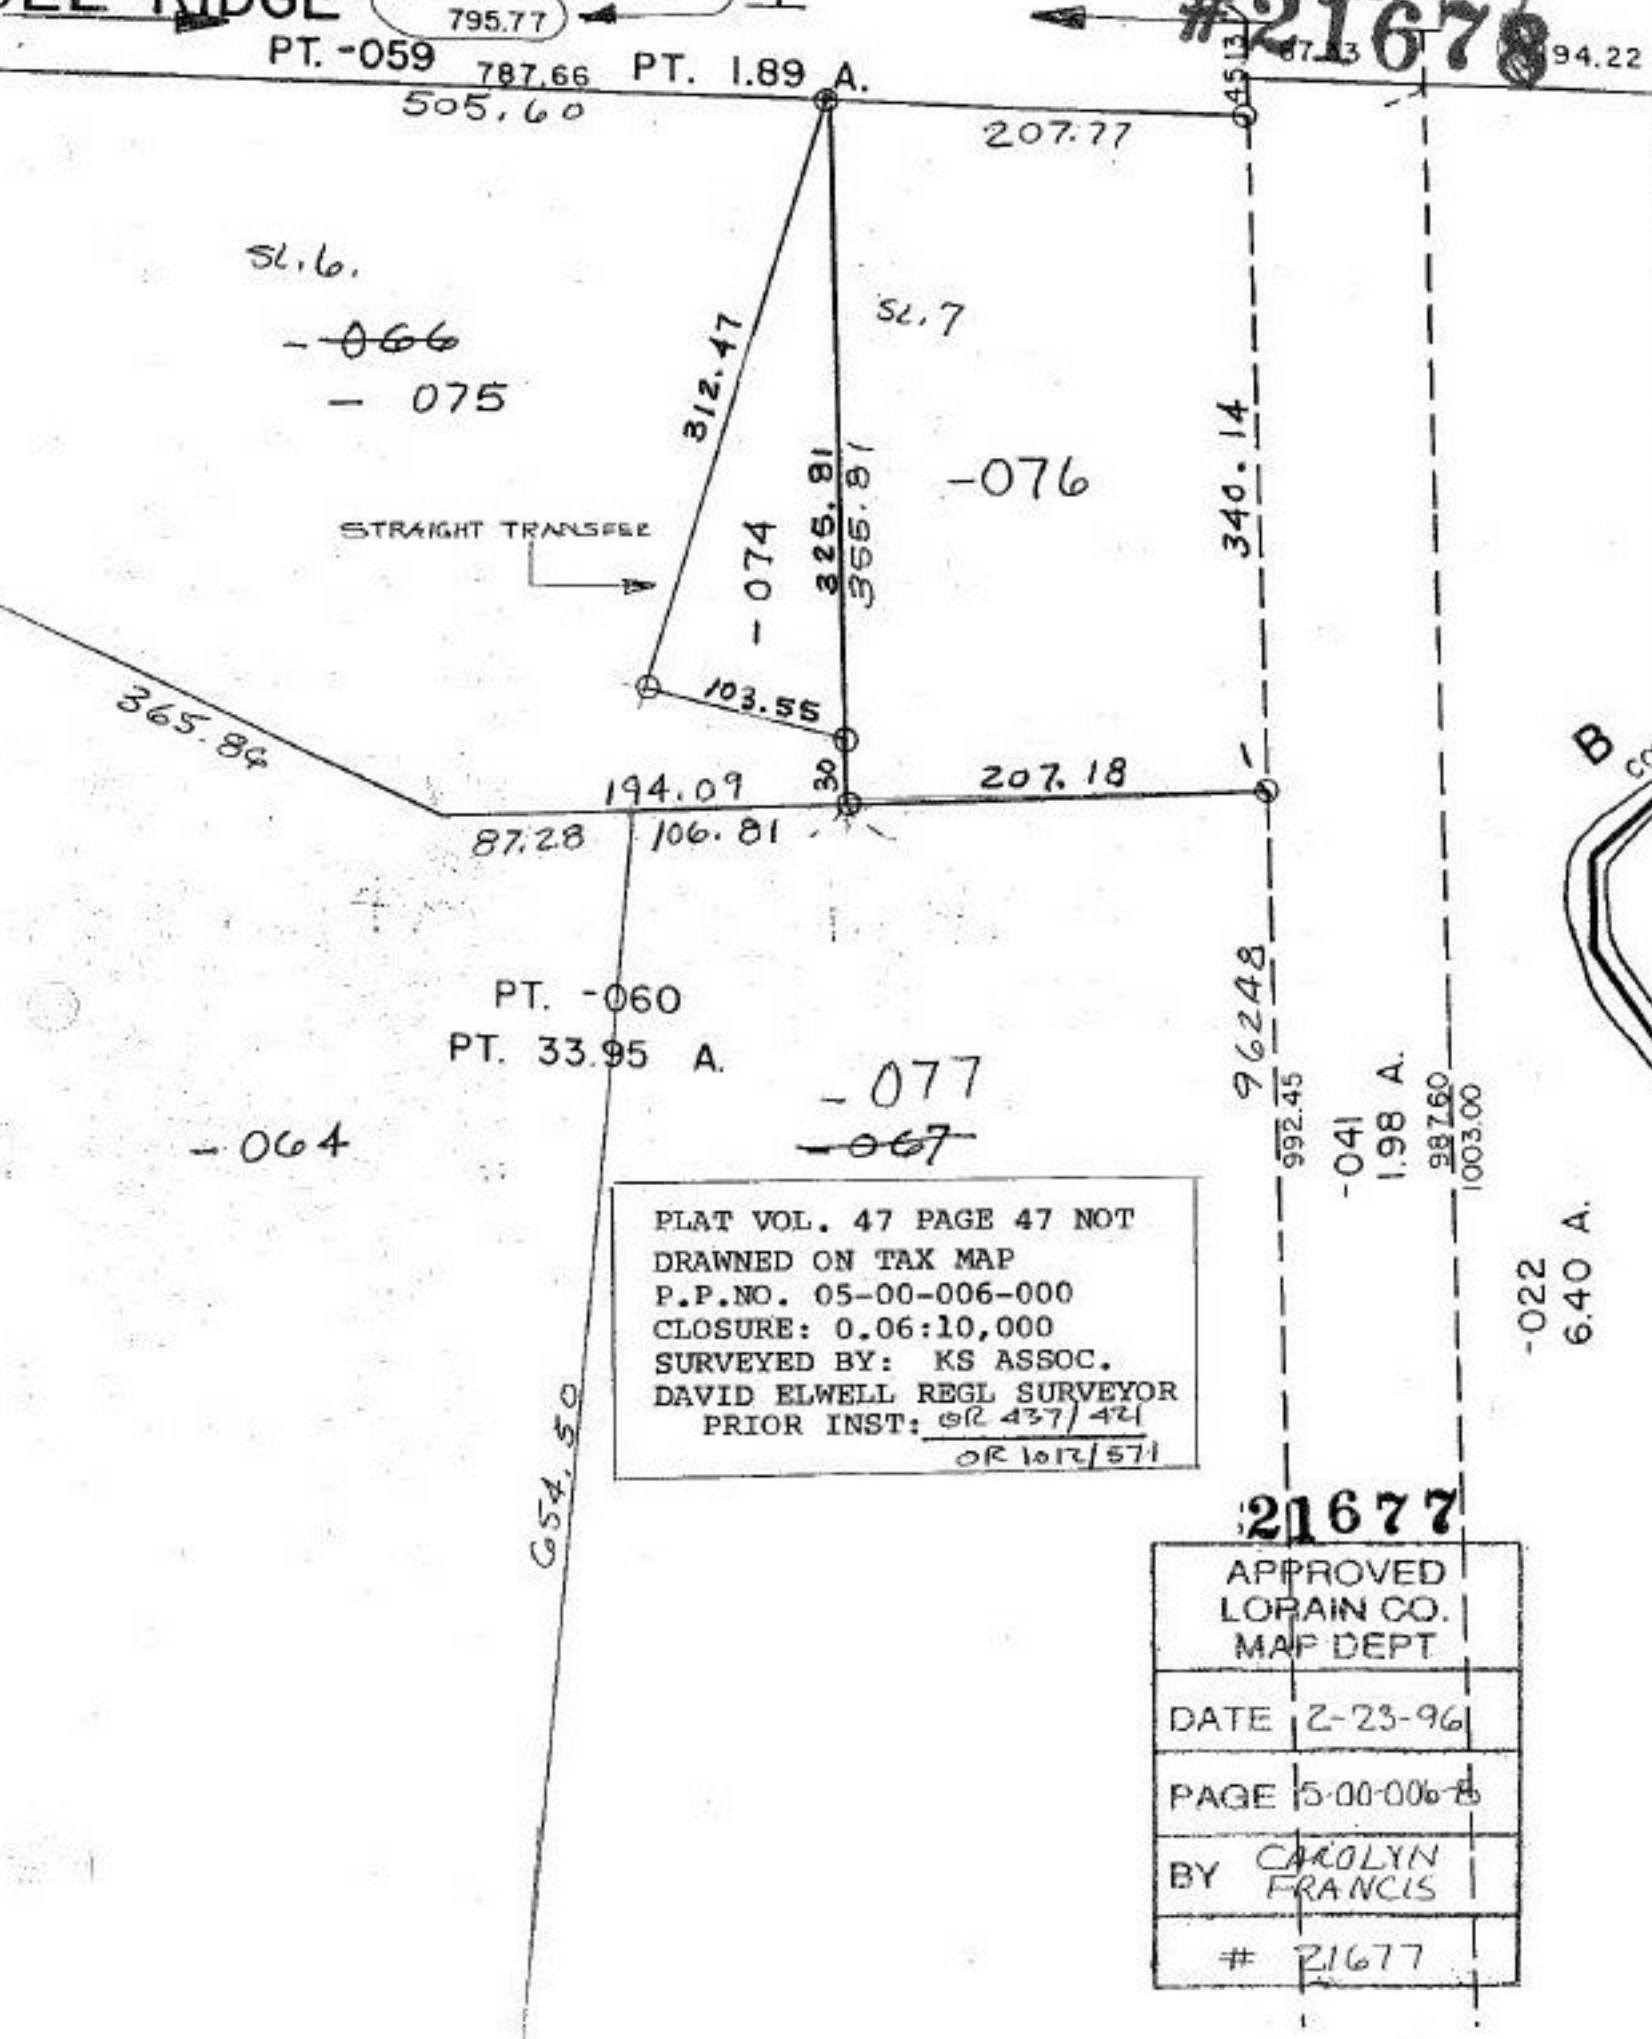

PLAT VOL. 47 PAGE 47 NOT  
 DRAWN ON TAX MAP  
 P.P.NO. 05-00-006-000  
 CLOSURE: 0.06:10,000  
 SURVEYED BY: KS ASSOC.  
 DAVID ELWELL REG. SURVEYOR  
 PRIOR INST: OR 437/421  
OR 1072/571

<b>21677</b>	
APPROVED	LORAIN CO. MAP DEPT
DATE	2-23-96
PAGE	5-00-006-B
BY	CAROLYN FRANCIS
#	21677