
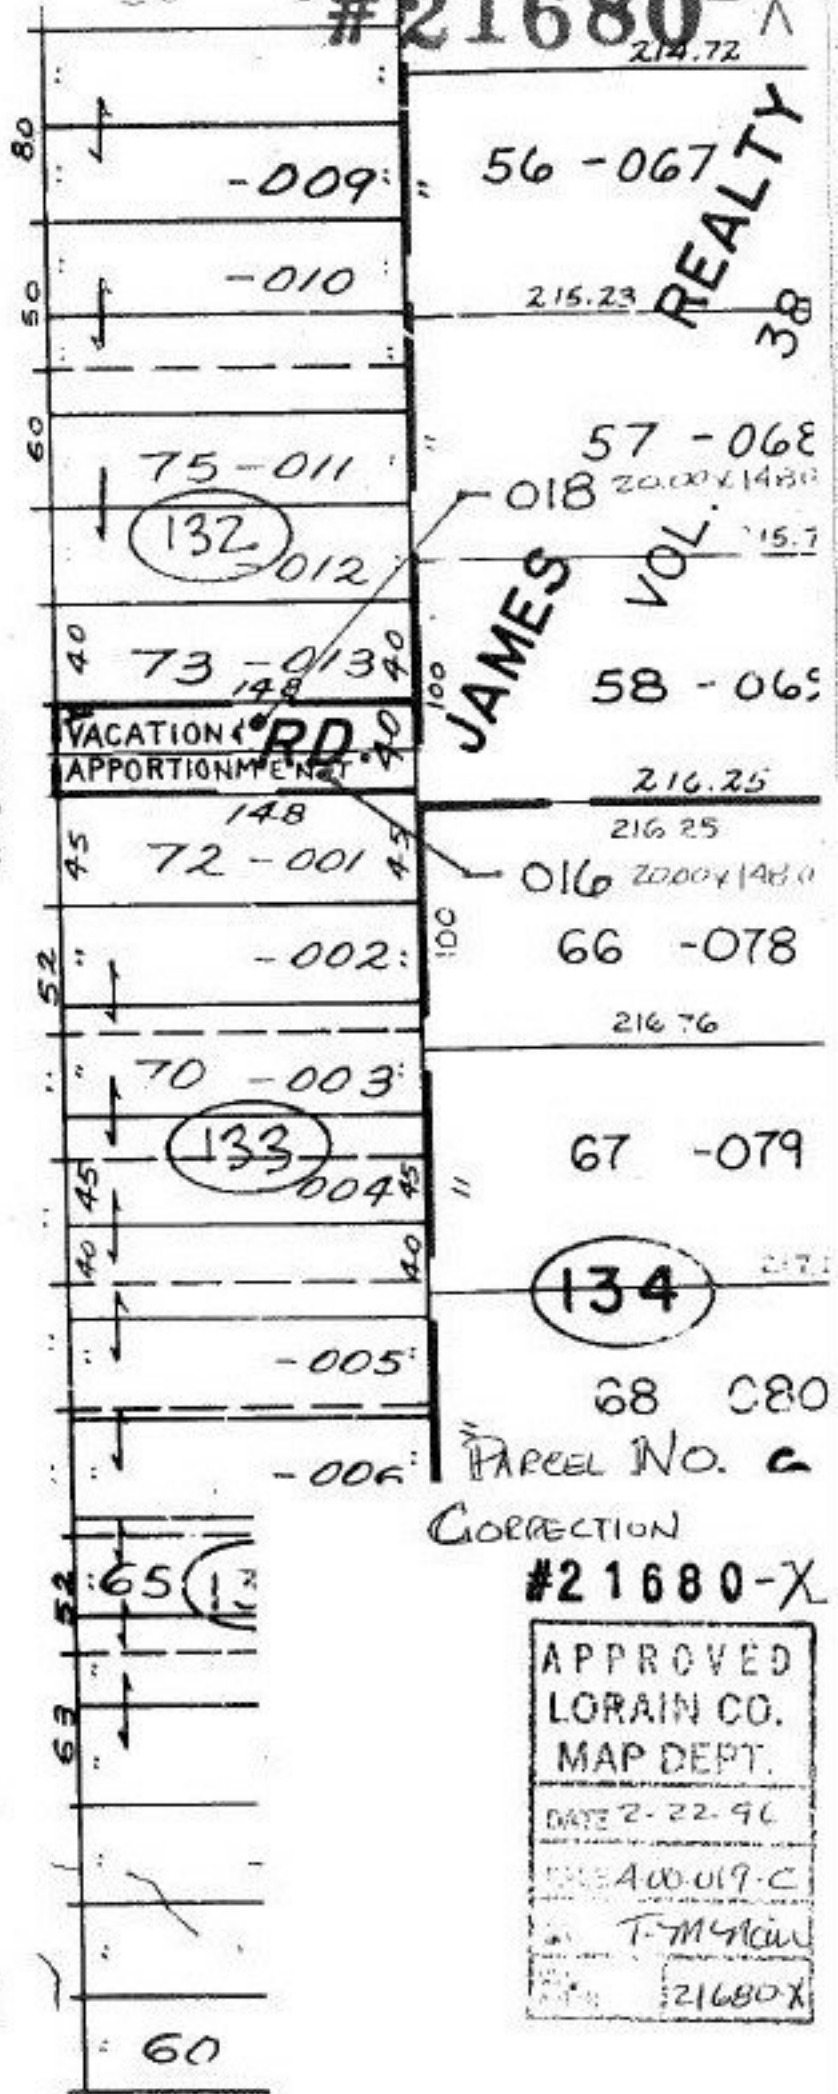


#21680-X  
214.72

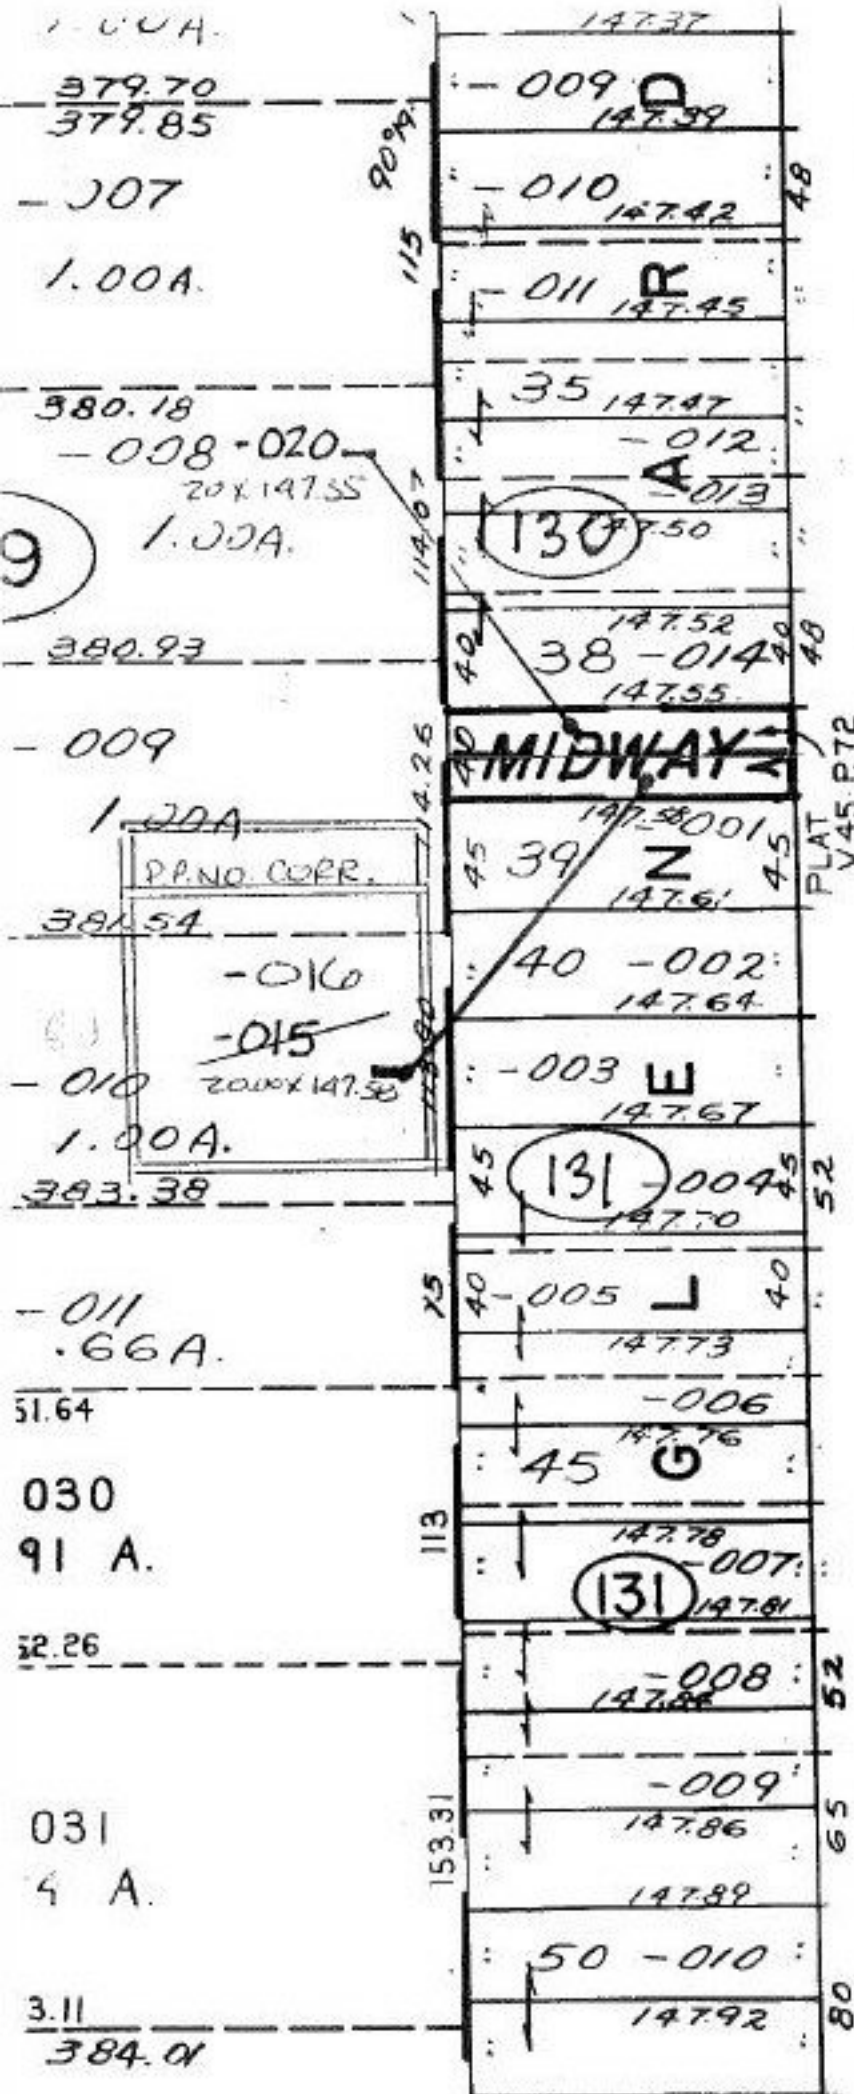

CORRECTION  
#21680-X  
APPROVED  
LORAIN CO.  
MAP DEPT.  
DATE 2-22-96  
FILE 400-019-C  
T-MACIN  
21680X