


#21680

P.P.NO.	01-00-027-000-
PRIOR INST:	O.R. 1193/313
CLOSURE:	3.05ac. 0.57:10,000
	2.10ac. 0.66:10,000
	2.11ac. 1:INP.
SURVEYED BY:	LAUNDON, SIMON CAHL & ASSOC.
	ROGER SIMON REG. SURVEYOR

TAX MAP PG. OUT OF SCALE

COOPER - FOSTER - PARK RD

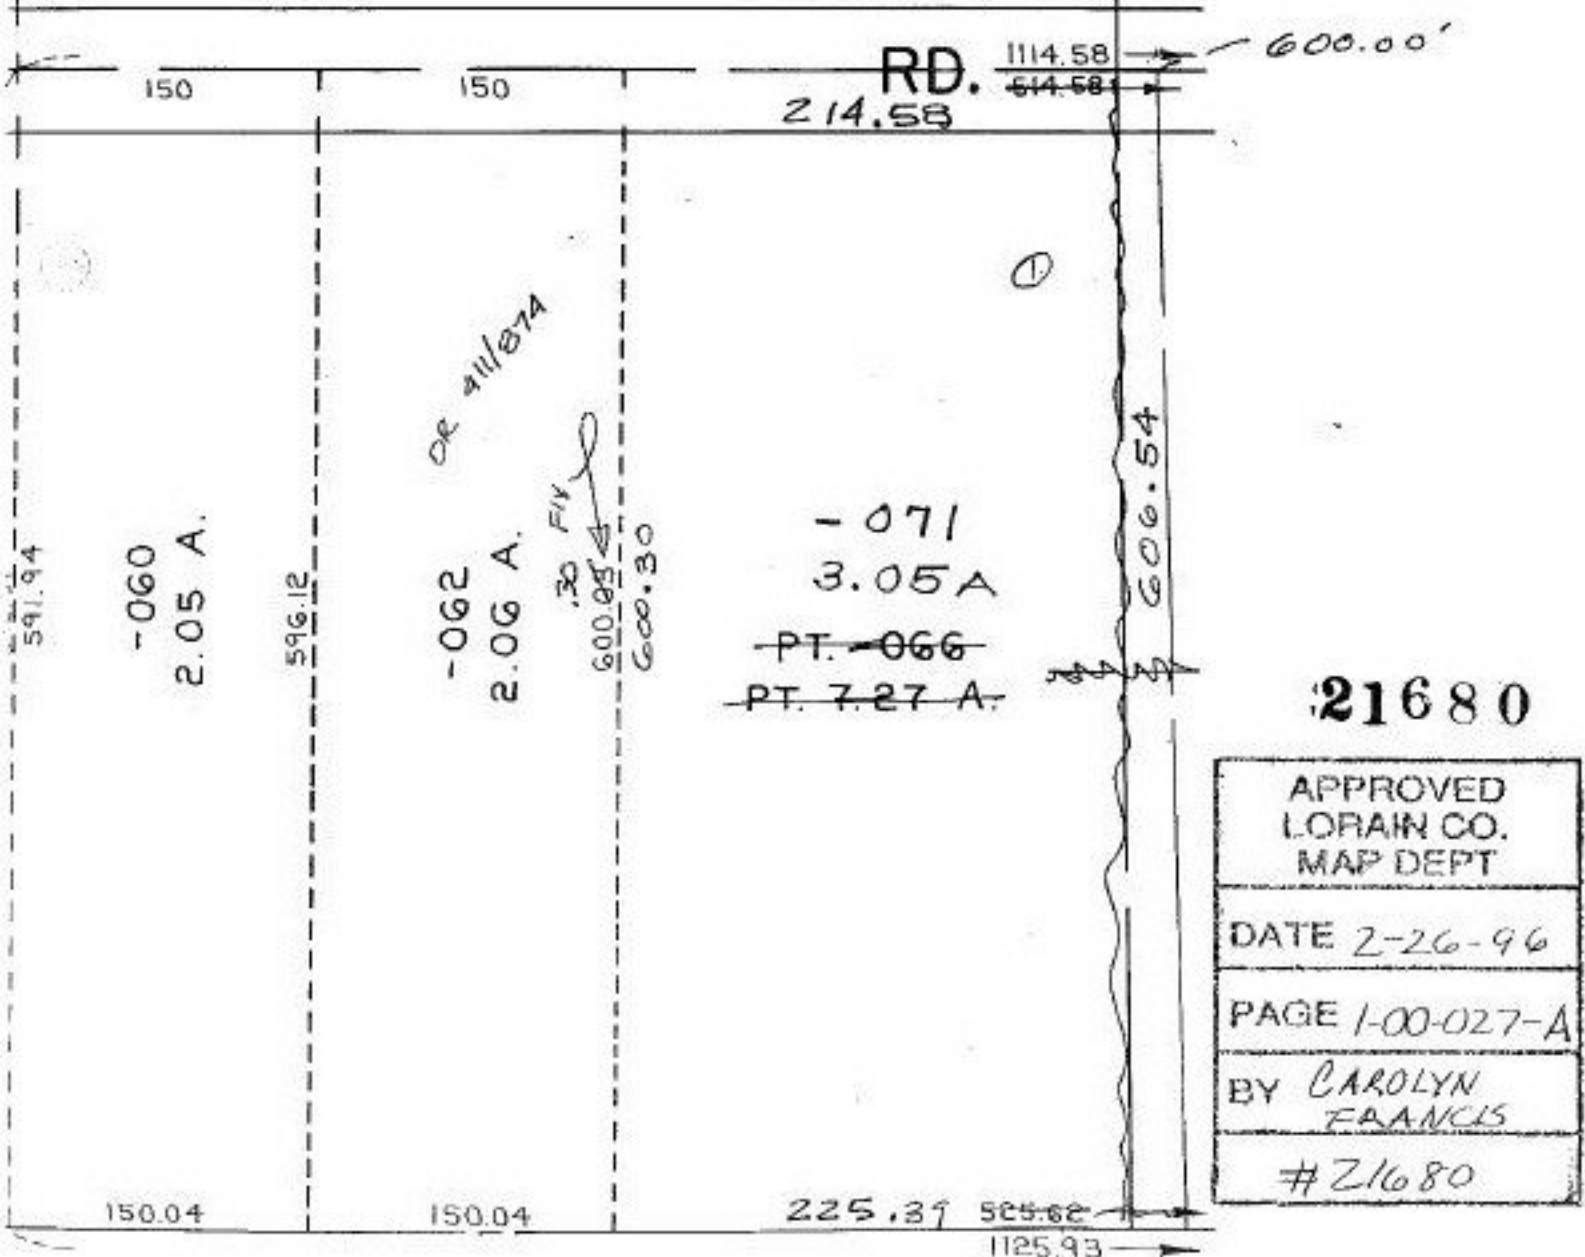

#21680

APPROVED LORAIN CO. MAP DEPT
DATE 2-26-96
PAGE 1-00-027-A
BY CAROLYN FRANCIS
#21680