

101

-032
-013


9-10-A

9.10 A

P.P. NO. 16-00-003-101-
PRIOR INST. PV. 454 5.207
CLOSURE: 1, 2 1: INF.
SURVEYED BY: ANDREW E.
RUDY R.S. MARCH 1995

North

SEE 16-00-003-B

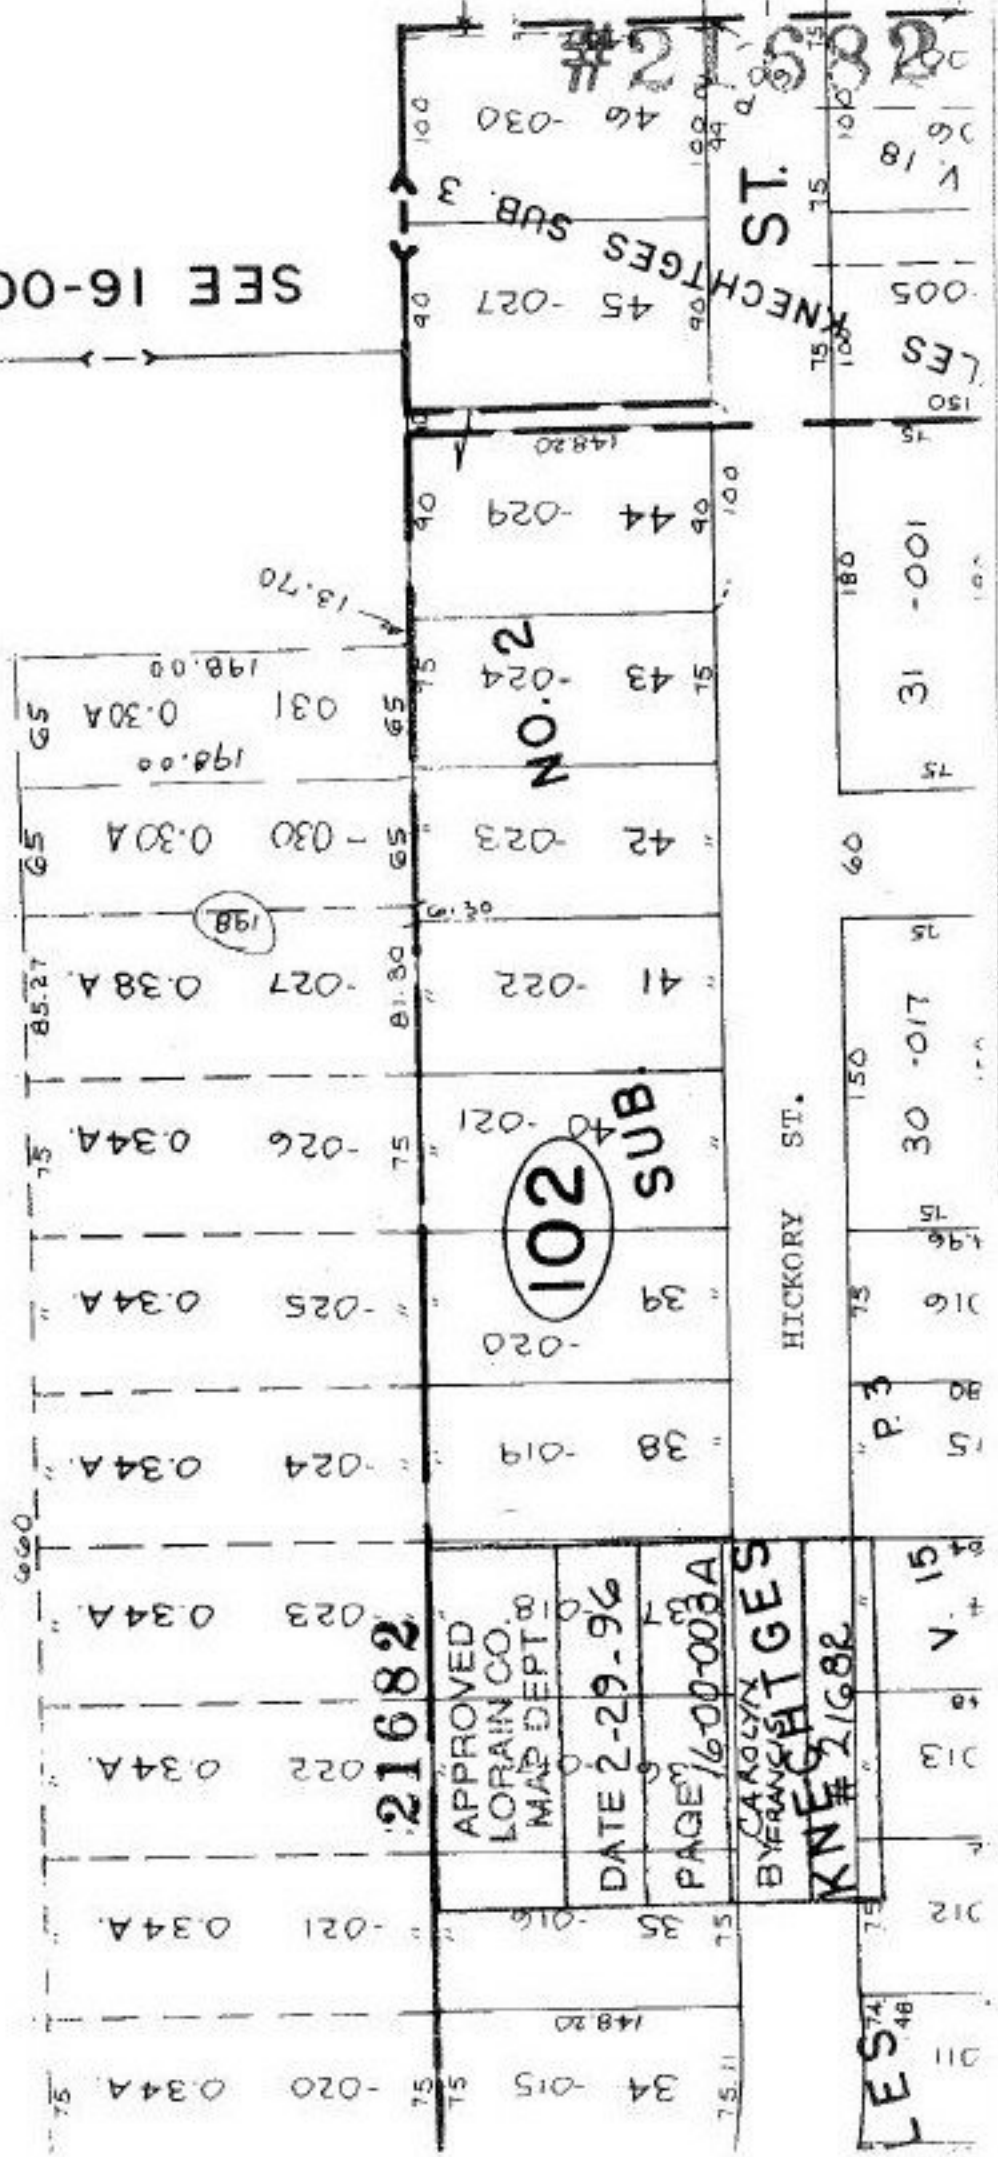

21682

APPROVED
LORAIN CO.
MAP DEPT.

DATE 2-29-96

PAGE 16-00-003A

BY CAROLYN
BRANSHAW
KNECHTGES
21682

LES 74 46

V. 15

D. 13

P. 3

1.96

30 -017

31 -001

LES 150

005

V. 18

06 18

02 18

HICKORY ST.

KNECHTGES ST.

SUB. 3

45 -027

46 -030

44 -029

43 -024

42 -023

41 -022

40 -021

39 -020

38 -019

35 -016

34 -015

35 -021

34 -020

0.30A

0.30A

0.30A

0.38A

0.34A

0.34A

13.70

198.00

198.00

14820

14820

#2 582