


SEE LOR-252-3.25	
PARCEL(S)	
4-WD	CLOSURE 1:166,666
4-EL	1:139,500

A=209.75
 CH=209.26
 CB S25-03-08 W
 R=879.93

P.P.NO. 12-00-037-000-
 PRIOR INST: DV.1253/142
 CLOSURE: 0.06:10,000
 SURVEYED BY: JAMES E. KENYON
 REG. SURVEYOR
 4-WD STATE OF OHIO RAW PLANS
 STATE ROUTE 252 SEC. 3.25

21699
 APPROVED
 LORAIN CO.
 MAP DEPT
 DATE 3-13-96
 PAGE 12-00-037B
 BY CAROLYN
 FRANCIS
 #21699

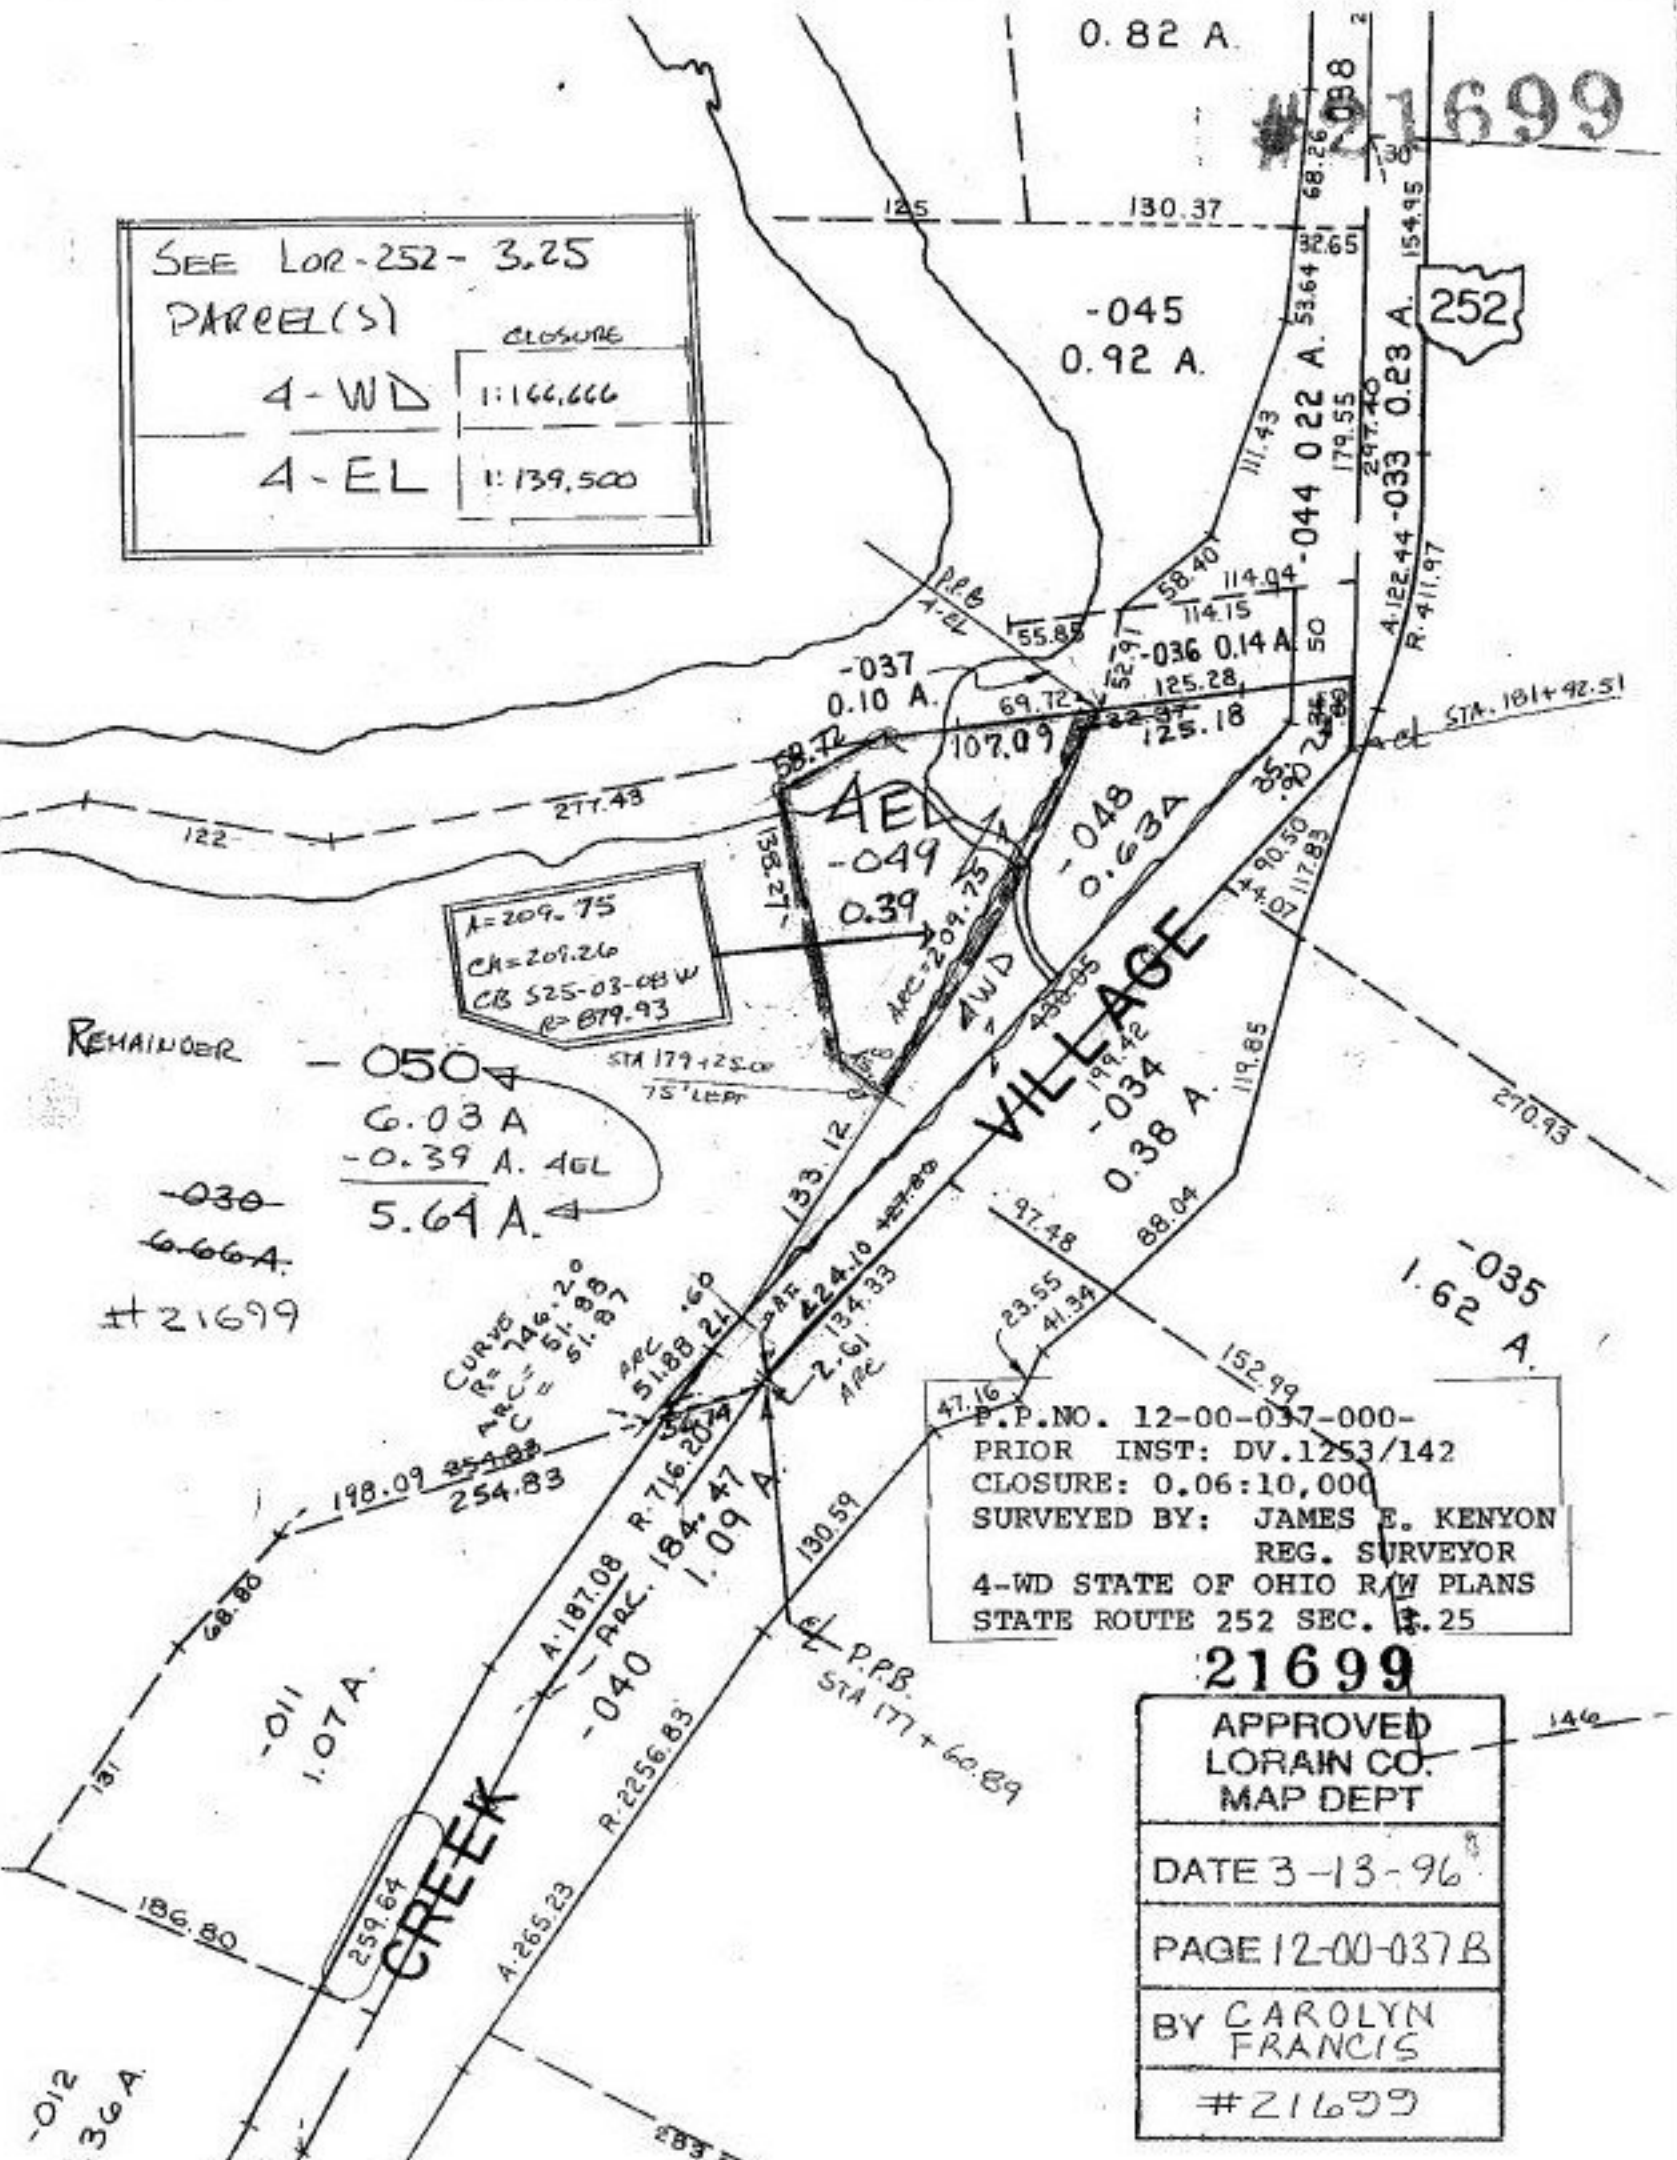

252

#21699

21699

CREEK

VILLAGE

REMAINDER

050
 6.03 A
 -0.39 A. 4GL
 5.64 A.

-030
 6.66 A.
 #21699

-012
 1.36 A.

-035
 1.62 A.

P.P.B.
 STA 177+60.89

STA 179+25.00
 75' LEFT

STA. 181+92.51

122

277.43

125

130.37

68.26
 68.26
 66.55

-045
 0.92 A.

111.43
 179.55
 297.40

A.122.44-033 0.23 A.
 R.411.97

-037
 0.10 A.

55.85
 69.72
 107.09
 125.28
 125.18

4EL
 -049
 0.39

-048
 0.63 A

-034
 0.38 A.

CURVE
 R=746.20
 ARC=51.88
 C=51.87

ARC 51.88
 R.716.20

ARC 2.61
 R.134.33

ARC 2.61
 R.134.33

152.99

-011
 1.07 A.

-040
 1.09 A.

186.80

259.64

A.265.23

A.187.08
 R.2256.83

130.59

97.48
 23.55
 41.34

88.04

152.99

270.93

146

283.87