


#21734-X

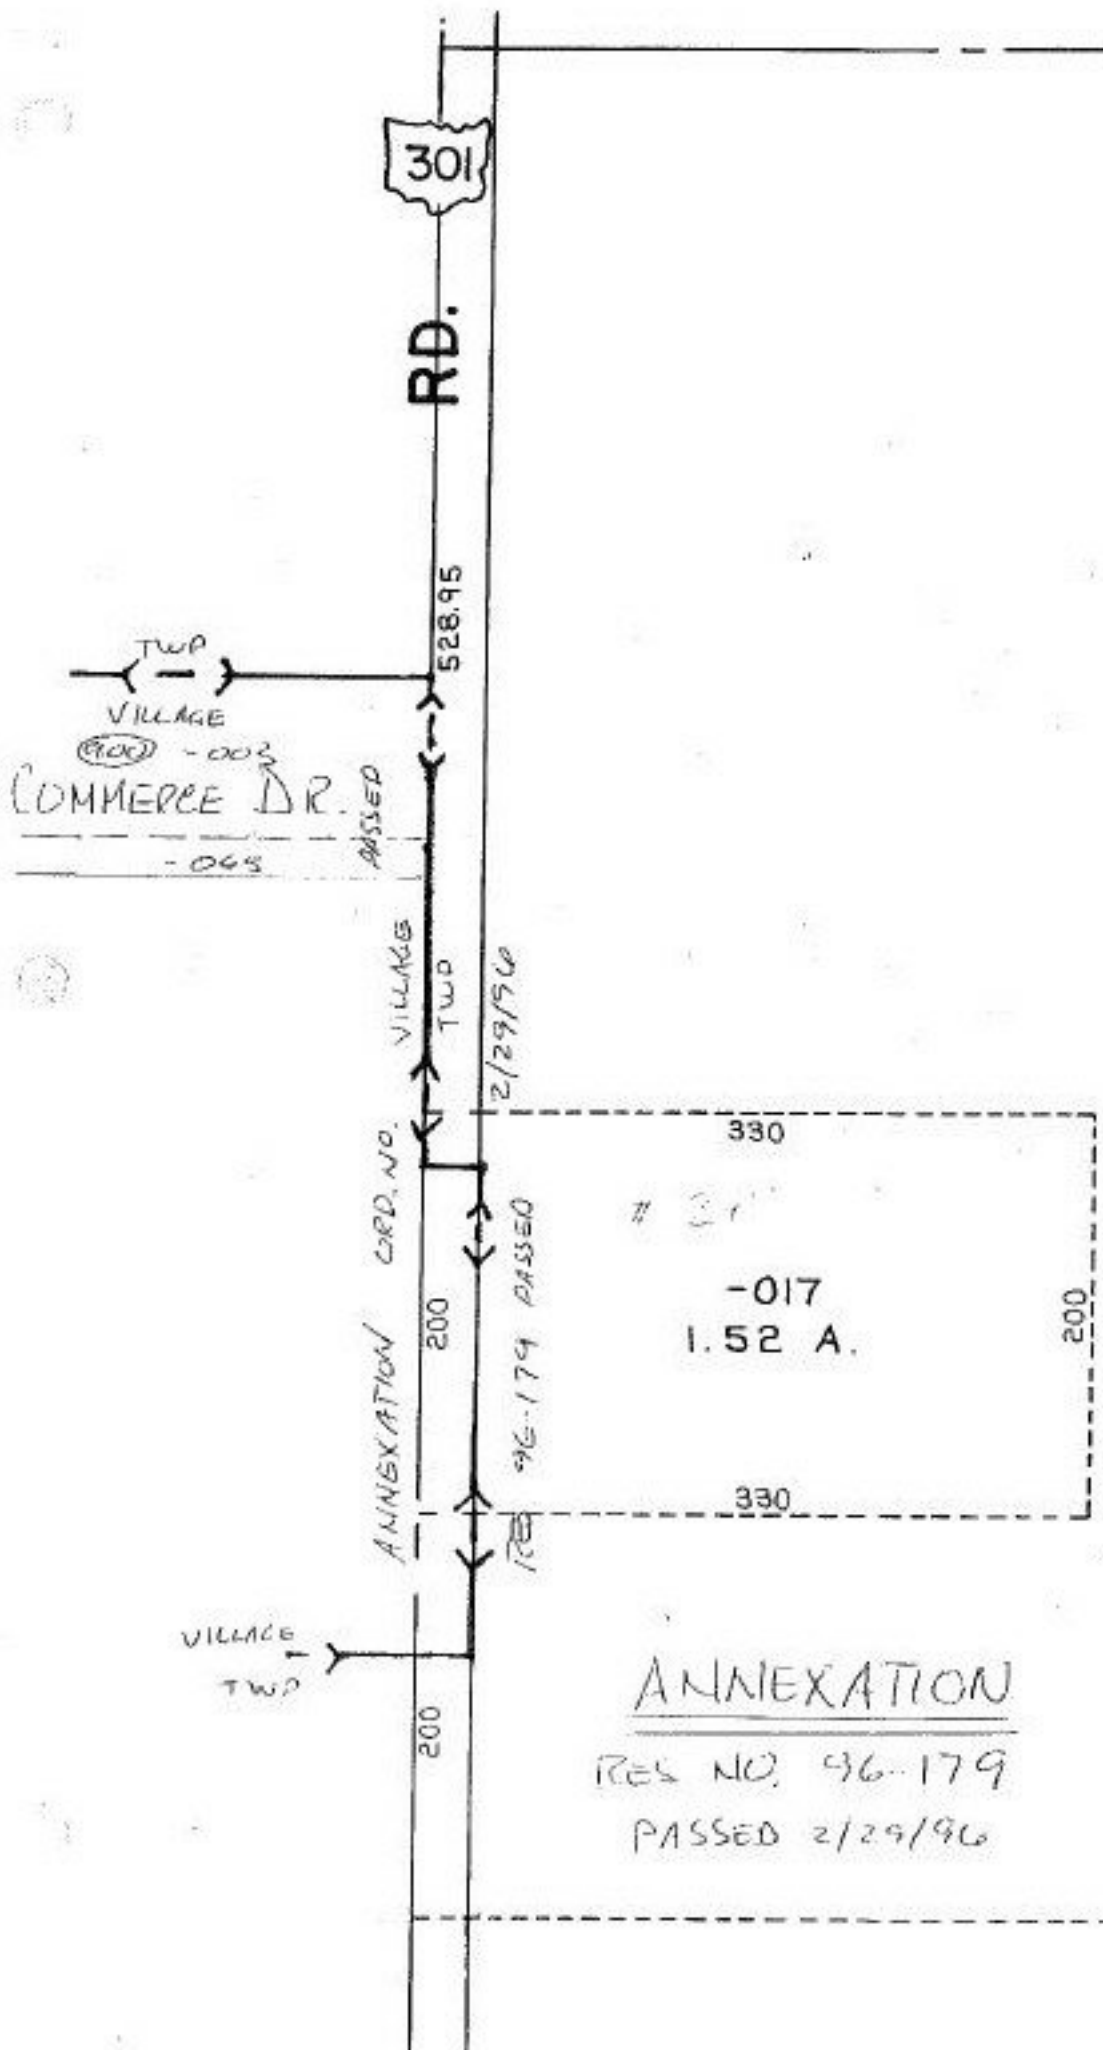

ANNEX.

#21734-X

ANNEXATION  
 RES NO. 96-179  
 PASSED 2/29/96

APPROVED	
LORAIN CO.	
MAP DEPT.	
DATE 4-16-96	
BY 1500 OLC A	
BY C.E. FRANCIS TH	
21734-X	