


#21734

-00-097-B

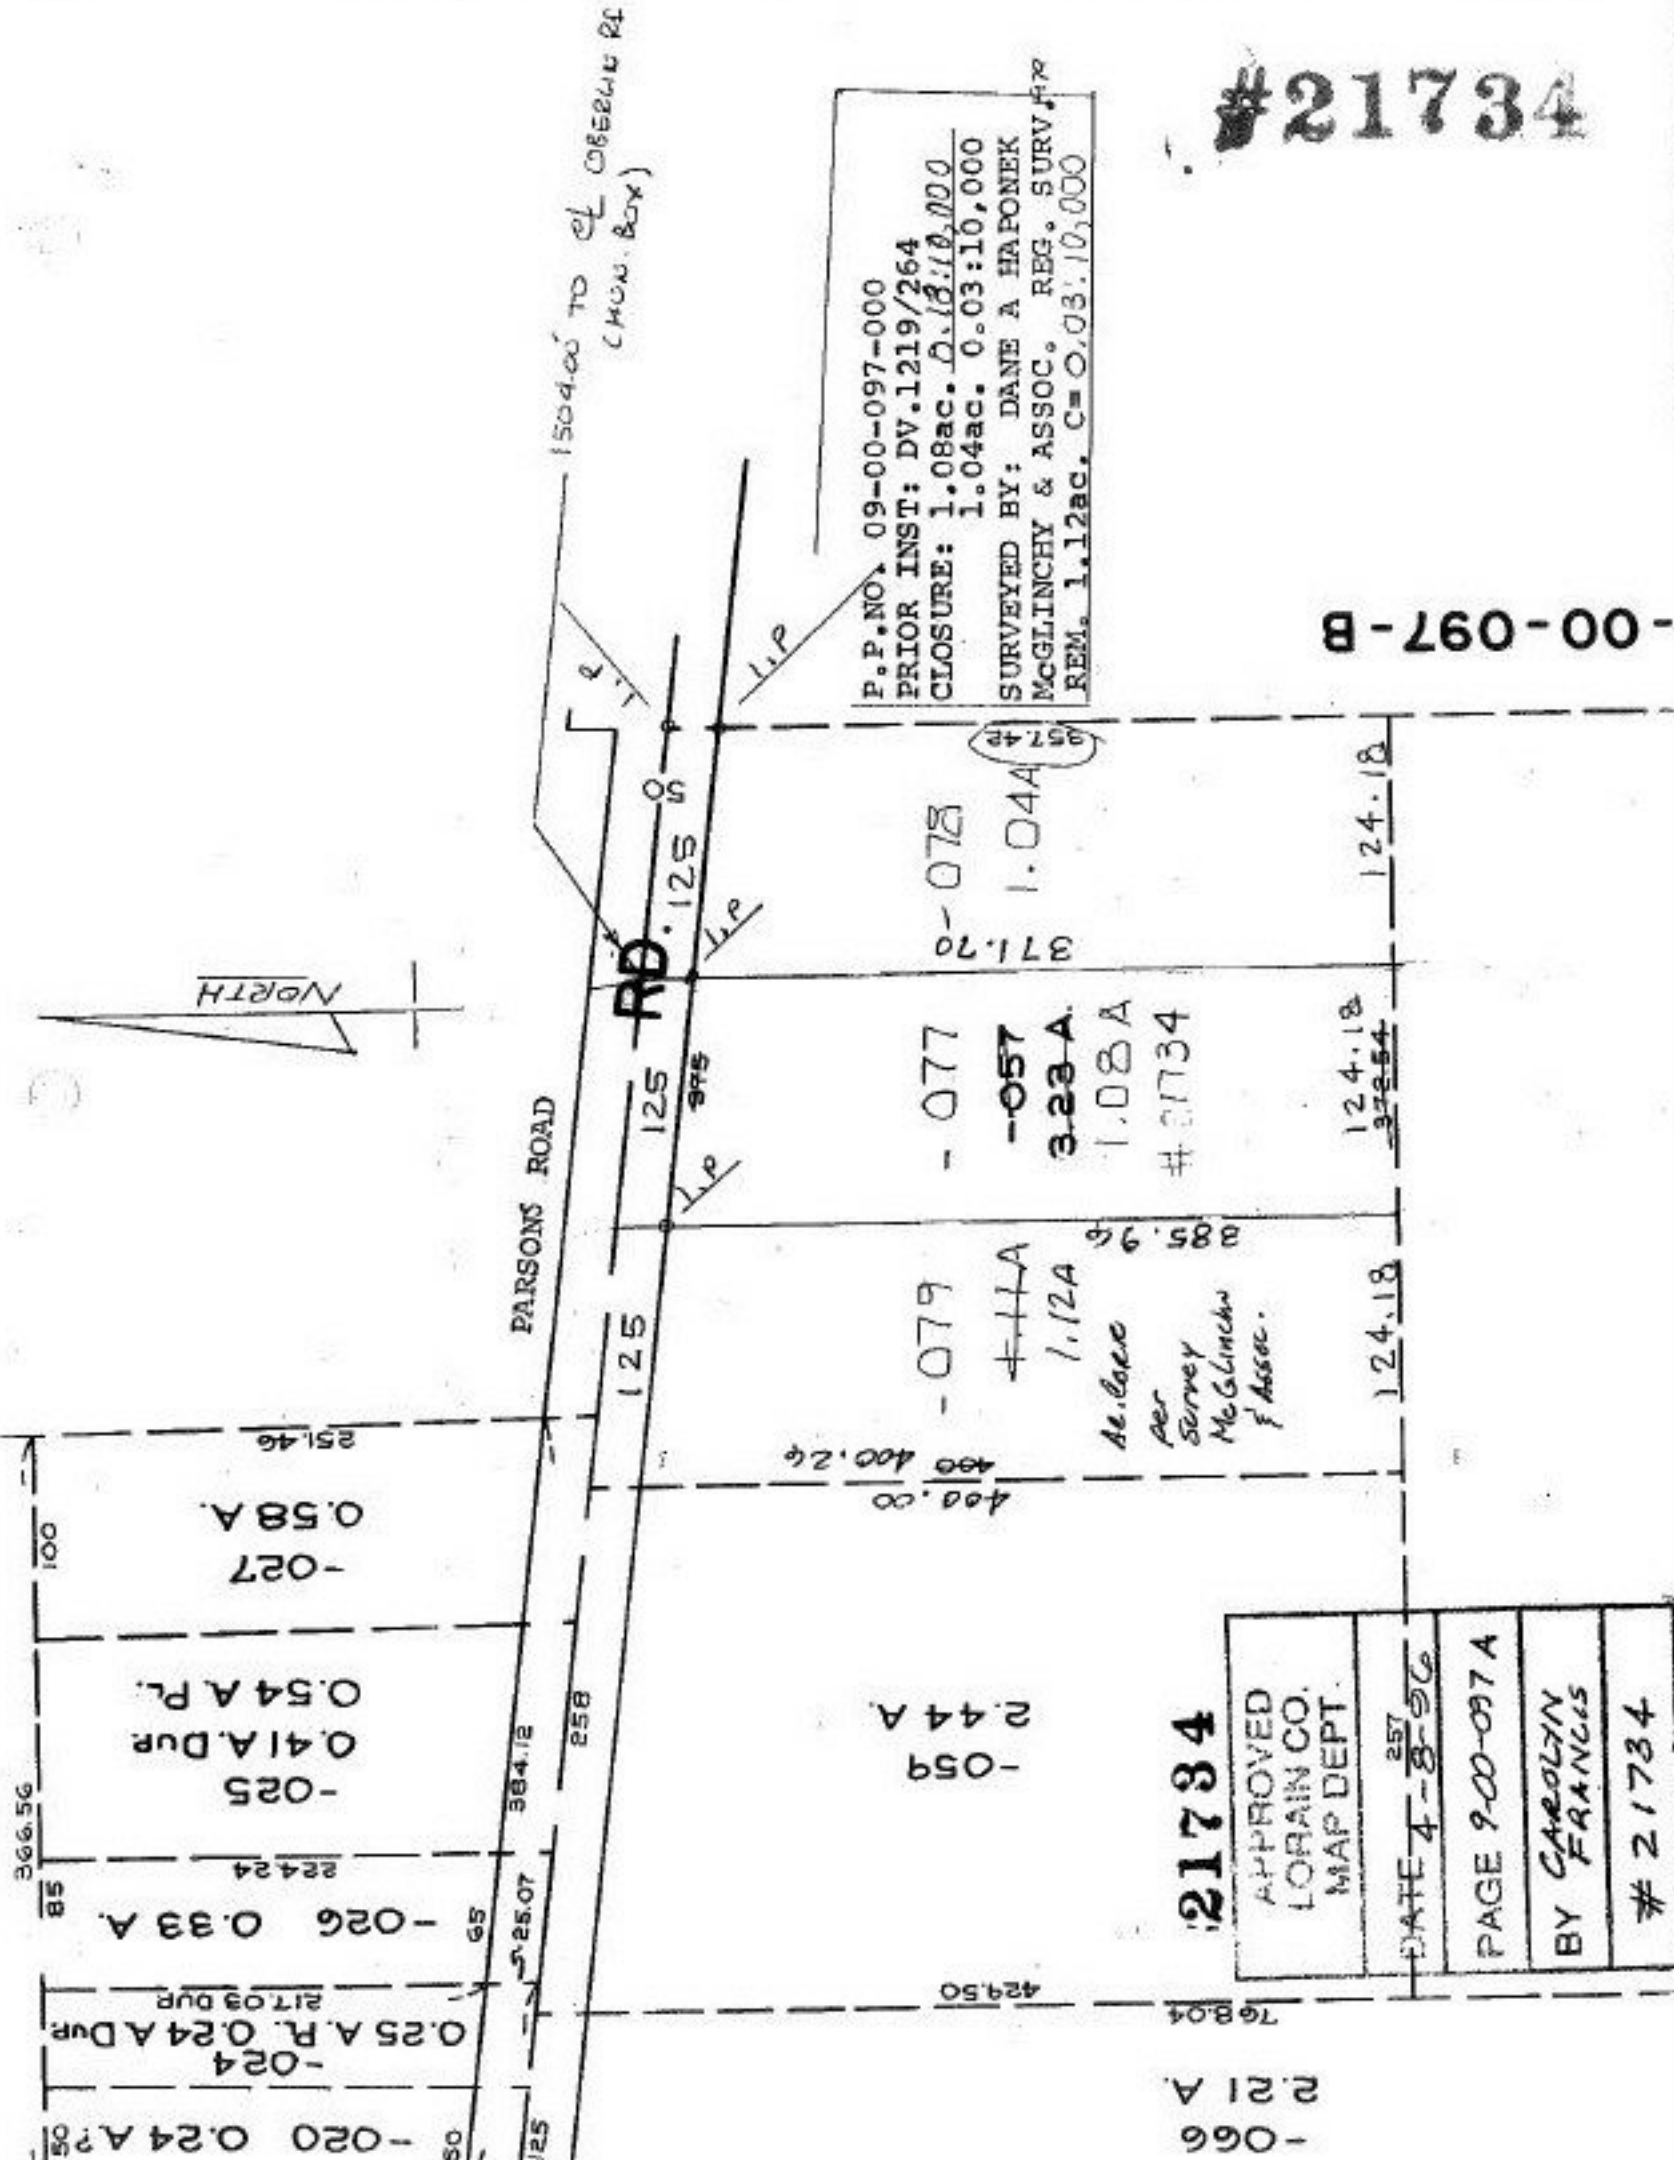

P.P. NO. 09-00-097-000
 PRIOR INST: DV.1219/264
 CLOSURE: 1.08ac. D.18.10.000
 1.04ac. 0.03:10,000
 SURVEYED BY: DANE A HAPONEK
 MCGLINCHY & ASSOC. REG. SURV.
 REM. 1.12ac. C=0.03:10,000

1504.00 TO EL OBSERV RE
 (MUN. BOX)

NORTH

PARSONS ROAD

RD. 125

-027 0.58 A

-025 0.41 A Dup
0.54 A Pl.

-026 0.33 A

-024 0.25 A R. 0.24 A Dup

-020 0.24 A 25

-078 371.70

-077

-079

-059 2.44 A

-057 3.23 A

1.12 A

1.08 A
21734

Ac. base
per
Survey
McGlinchy
& Assoc.

124.18
32954

124.18

124.18

21734

-066 2.21 A

76804

42450

125 975 125 975

125 975

125 975

