


#21737 X

SEE 15-00-055-B

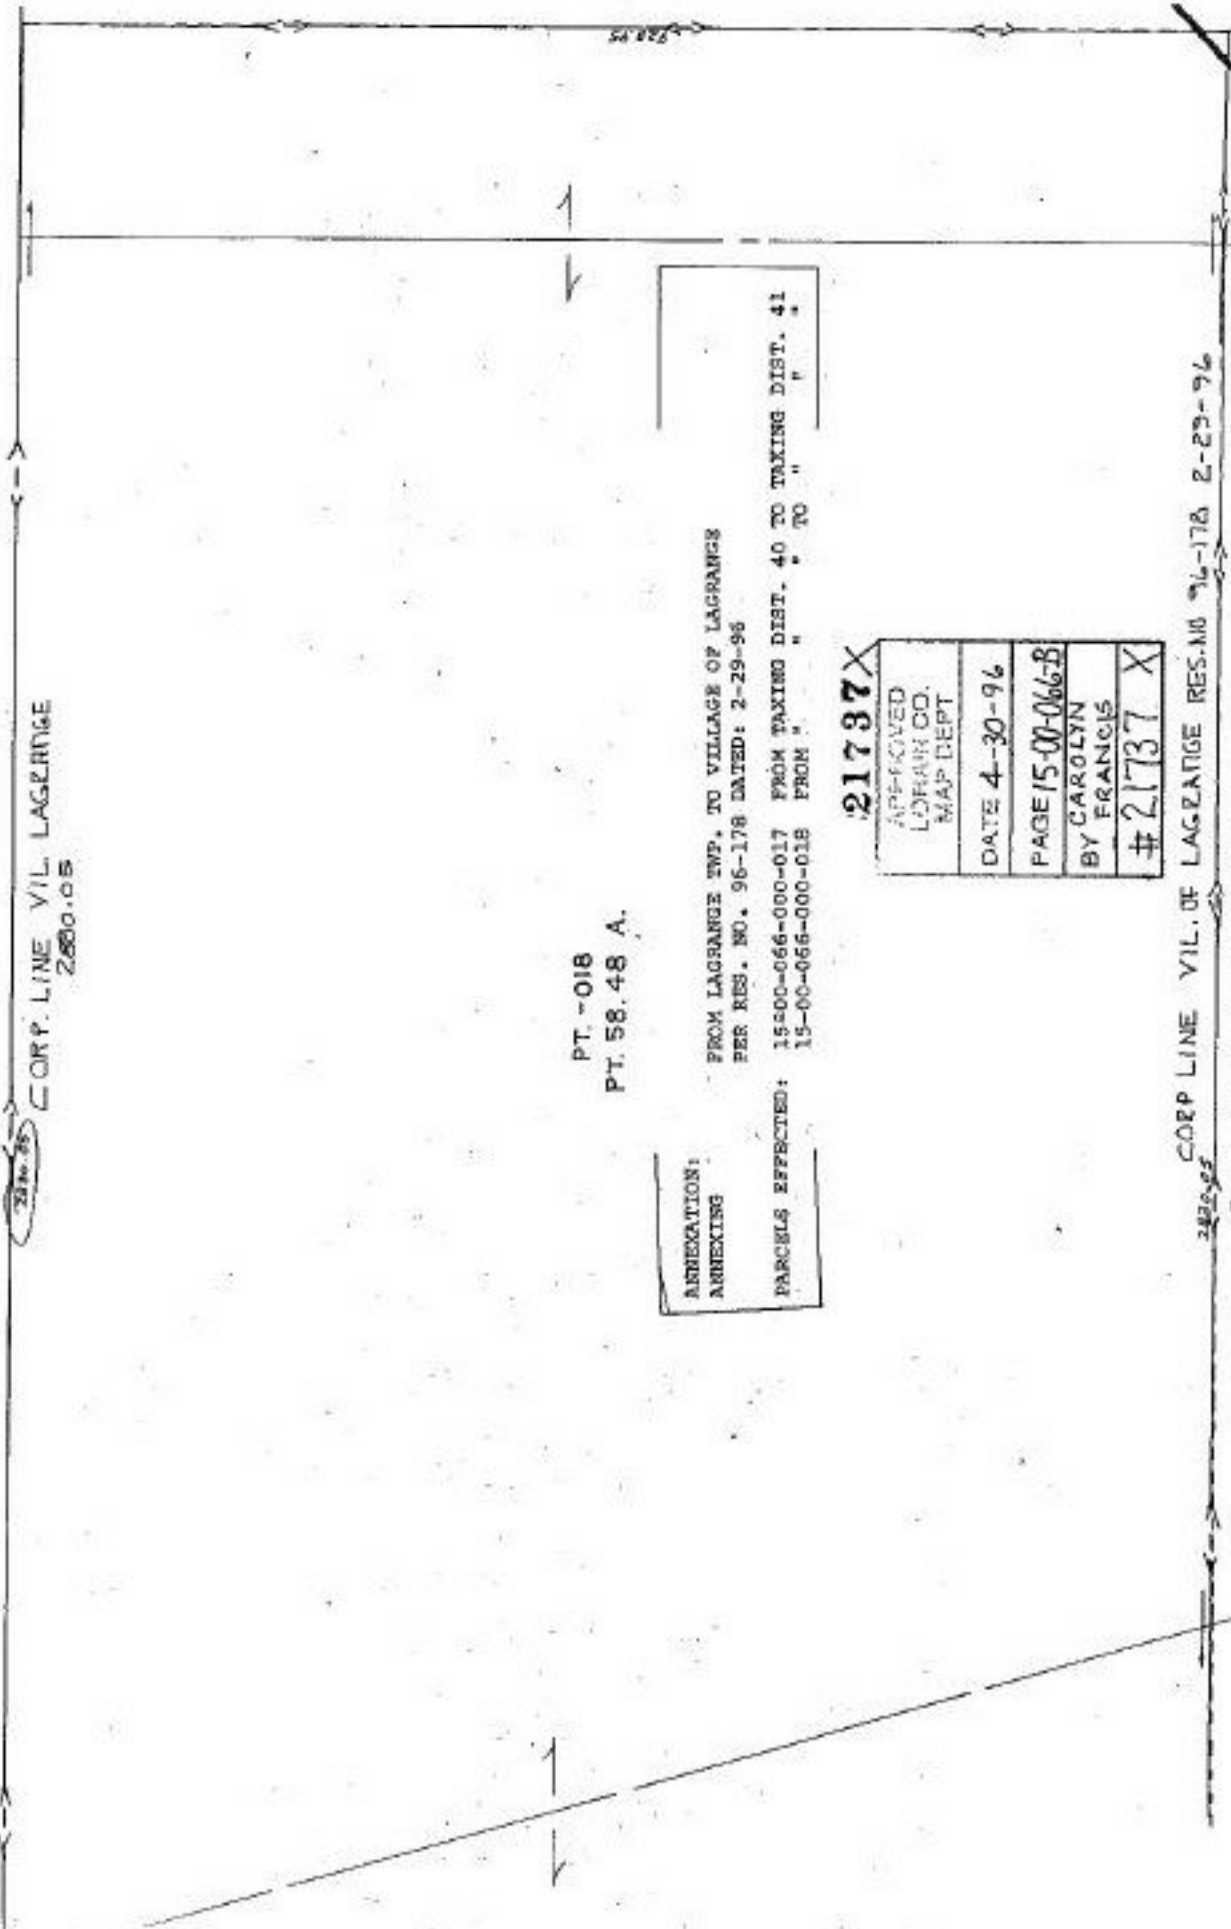

CORP. LINE VIL. LAGRANGE
2800.05

PT. -018
PT. 58.48 A.

ANNEXATION:
ANNEXING

FROM LAGRANGE TWP. TO VILLAGE OF LAGRANGE
PER RES. NO. 96-178 DATED: 2-29-96

PARCELS EFFECTED: 15-00-066-000-017 FROM TAXING DIST. 40 TO TAXING DIST. 41
15-00-066-000-018 FROM " TO "

21737 X

APPROVED LORAIN CO. MAP DEPT
DATE 4-30-96
PAGE 15-00-066-B
BY CAROLYN FRANCIS
21737 X

CORP LINE VIL. OF LAGRANGE RES. NO. 96-178 2-29-96
CORP. LINE LAGRANGE TWP