

MAP CORRECTION ONLY


#21743-X

112

Parcel Q  
-001  
11.84 A.

#21743-X

APPROVED  
LORAIN CO.  
MAP DEPT.  
DATE 4-18-96  
PAGE 3-00-079-B  
BY K. DYE  
J. HATFIELD  
WORD AFTER 21743X

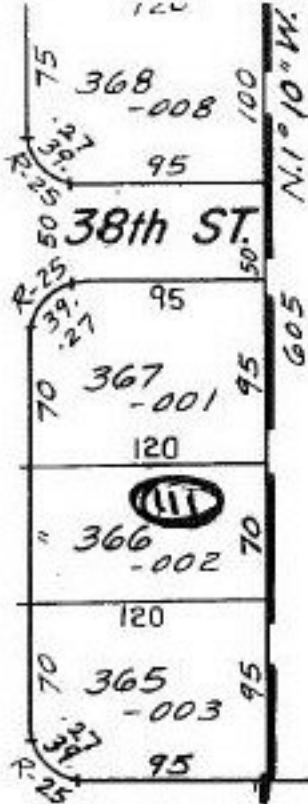


S. 88° 50' W 571.38

RIVERSIDE

MAP CORRECTION ONLY

3-00-079-B

SEE 3-00-079-A

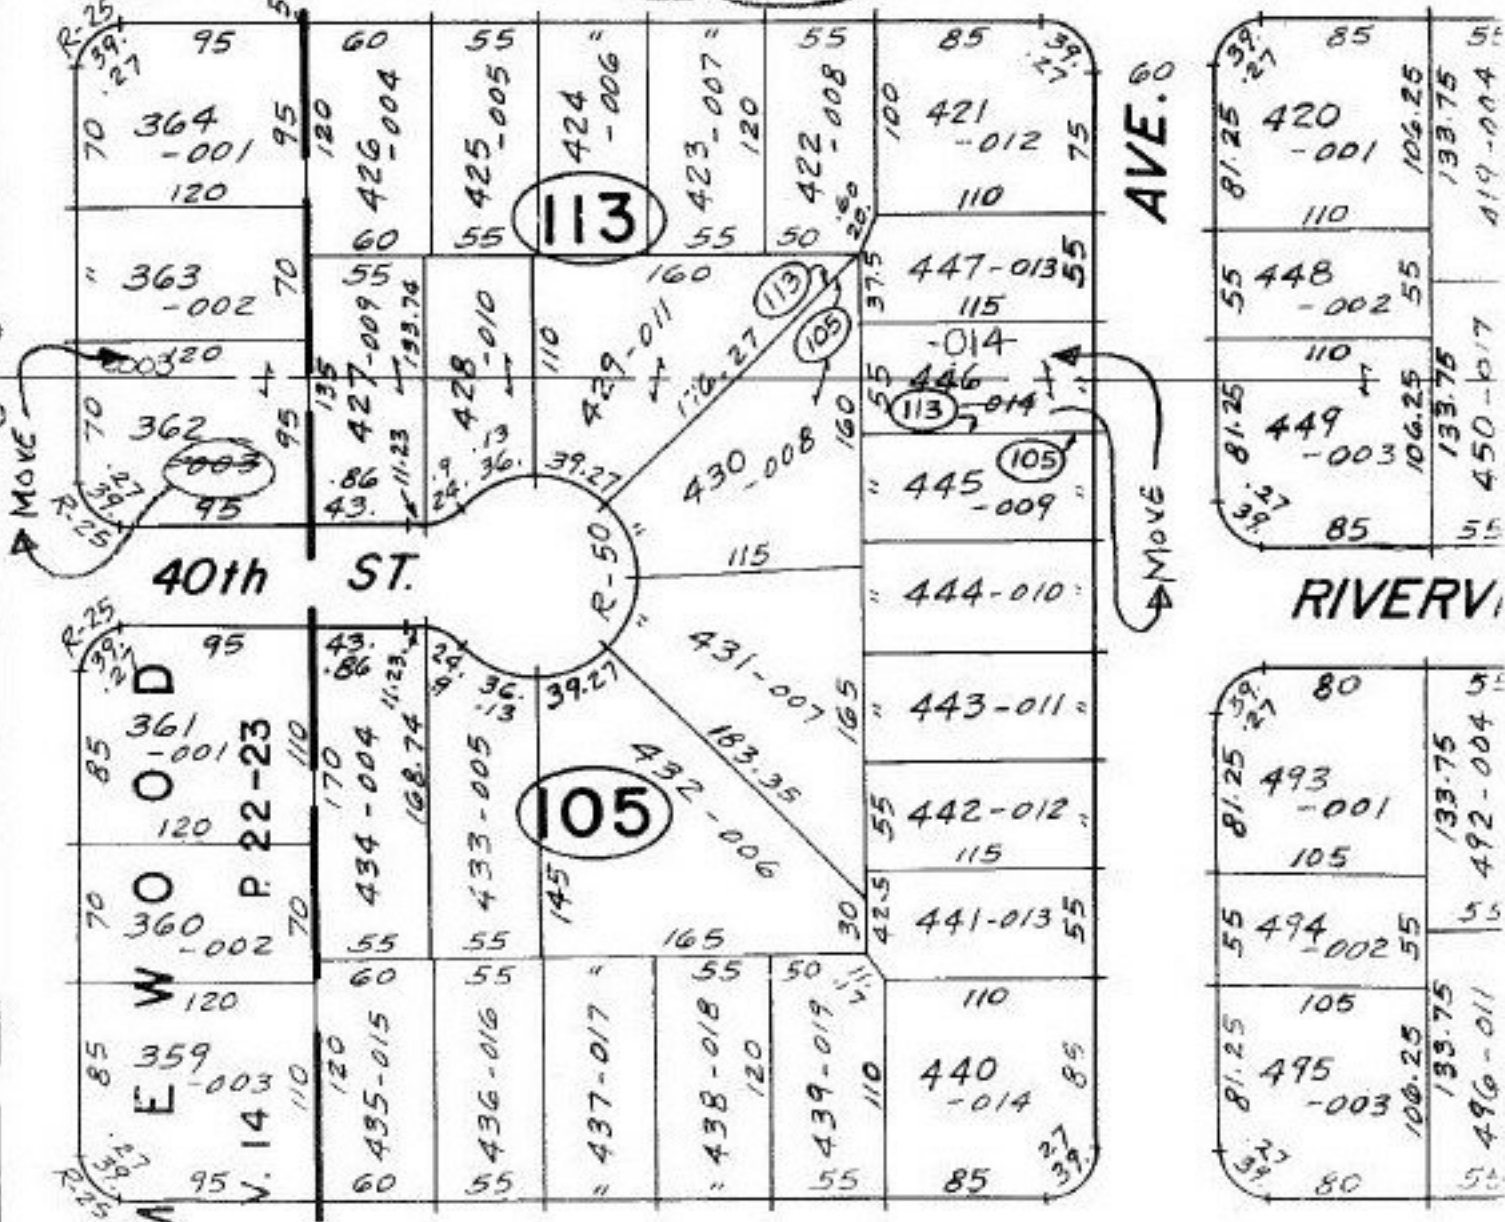

MOVE

AVE. 60

MOVE

R. 25

R. 25

WOOD

WOOD

P. 22-23

P. 22-23

P. 22-23

WOOD

WOOD

