

#21743

SEE 3-F

Re Number In Block 103

APPROVED
 LYRAIN CO.
 MAP DEPT.
 DATE 4-18-96
 PAGE 3-00-095-B
 BY S. DYE
 V. FIELD
 21743-X

D3-08-086-102-018


Pt. 03-00-089-101-021
Pt. 11.047

003 40R 101

007
53R

017
57A

018
30A

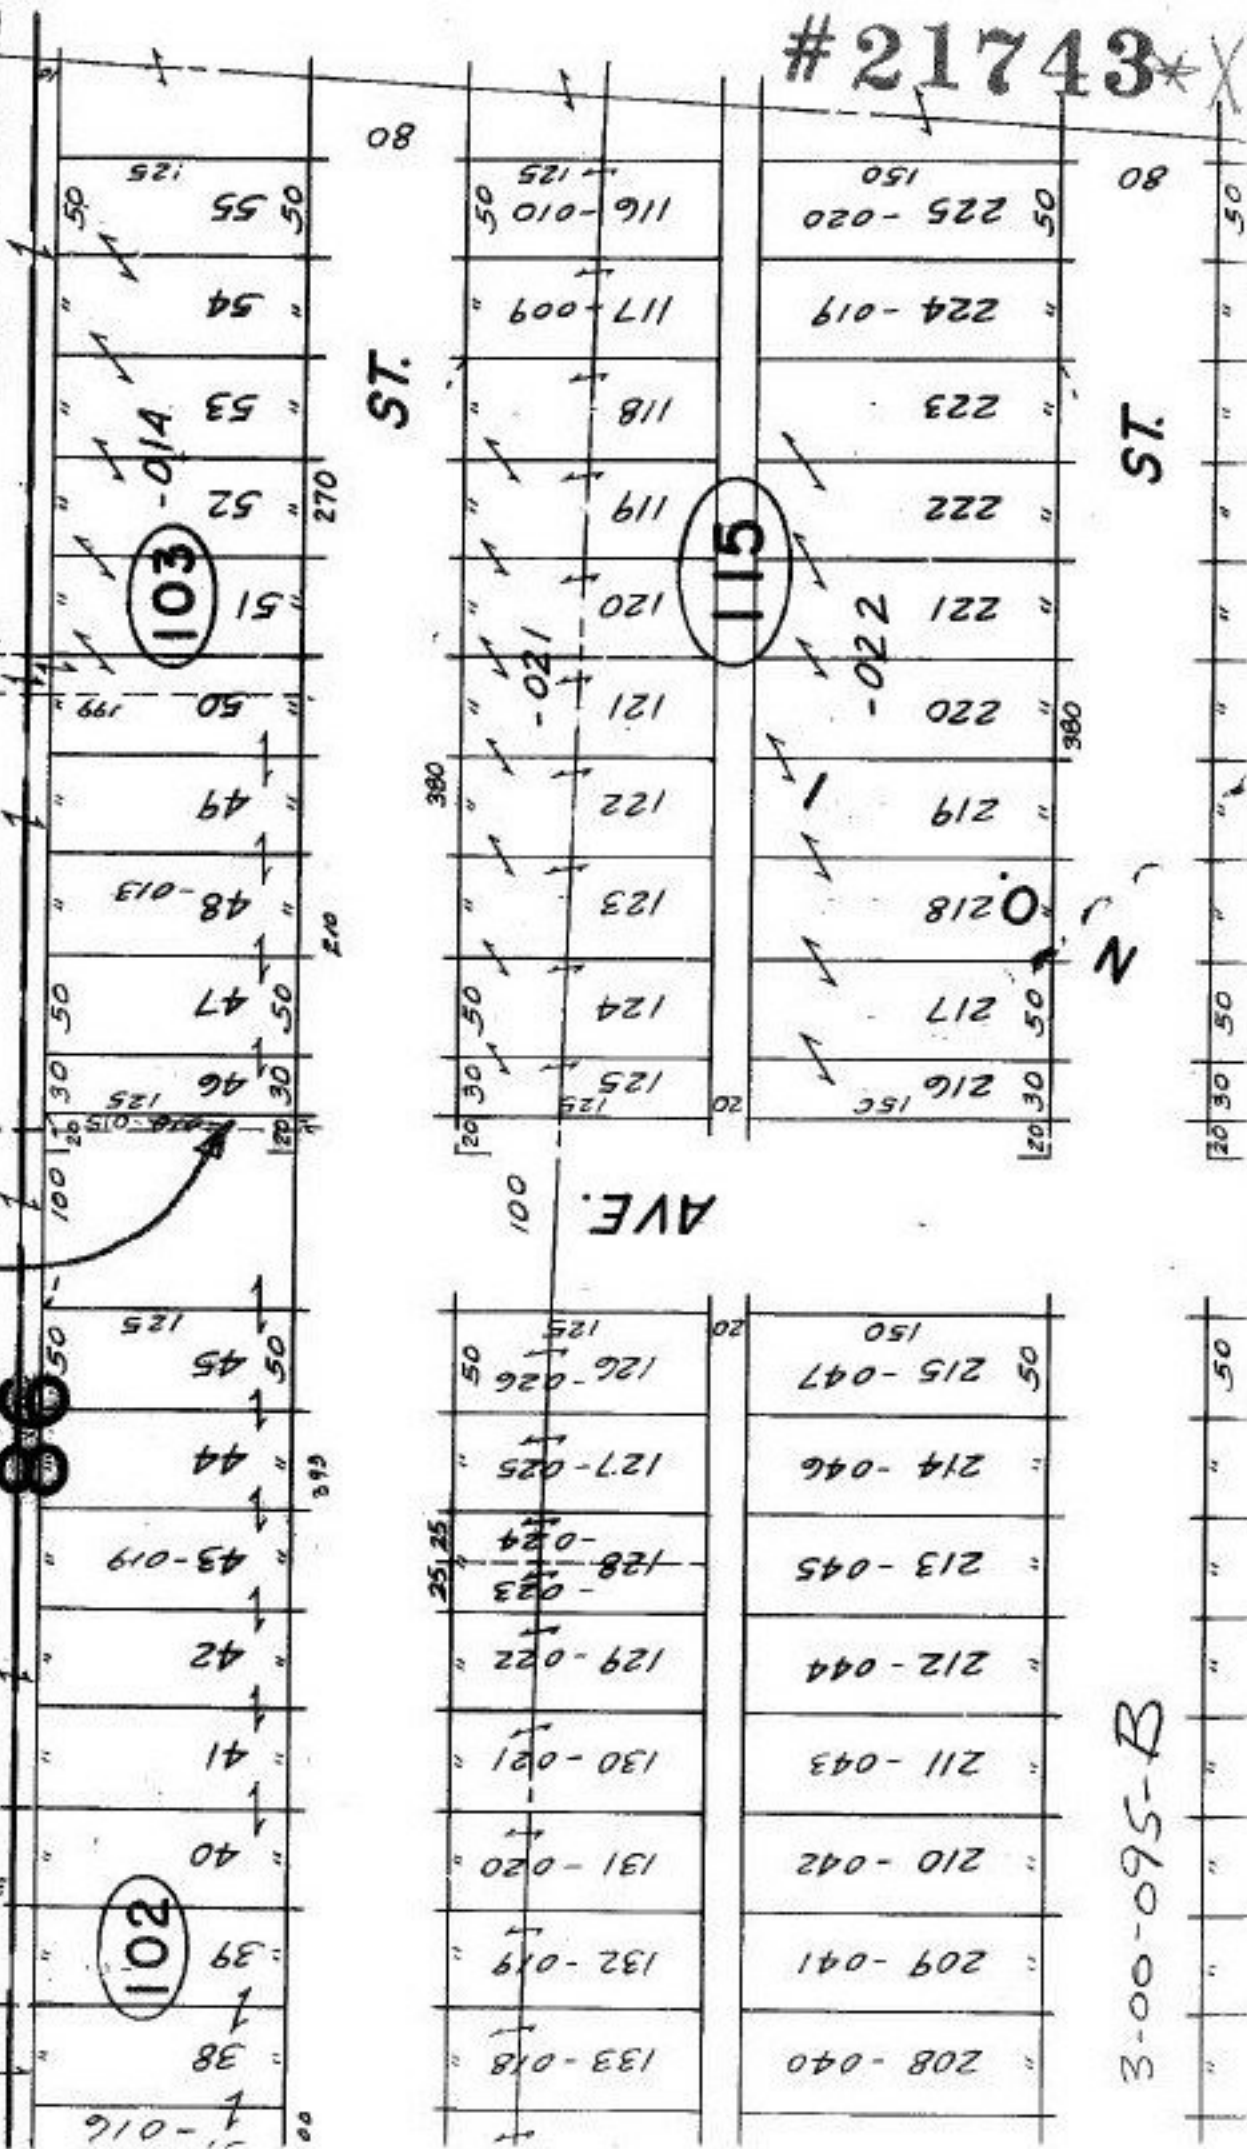

#21743*