


#21744

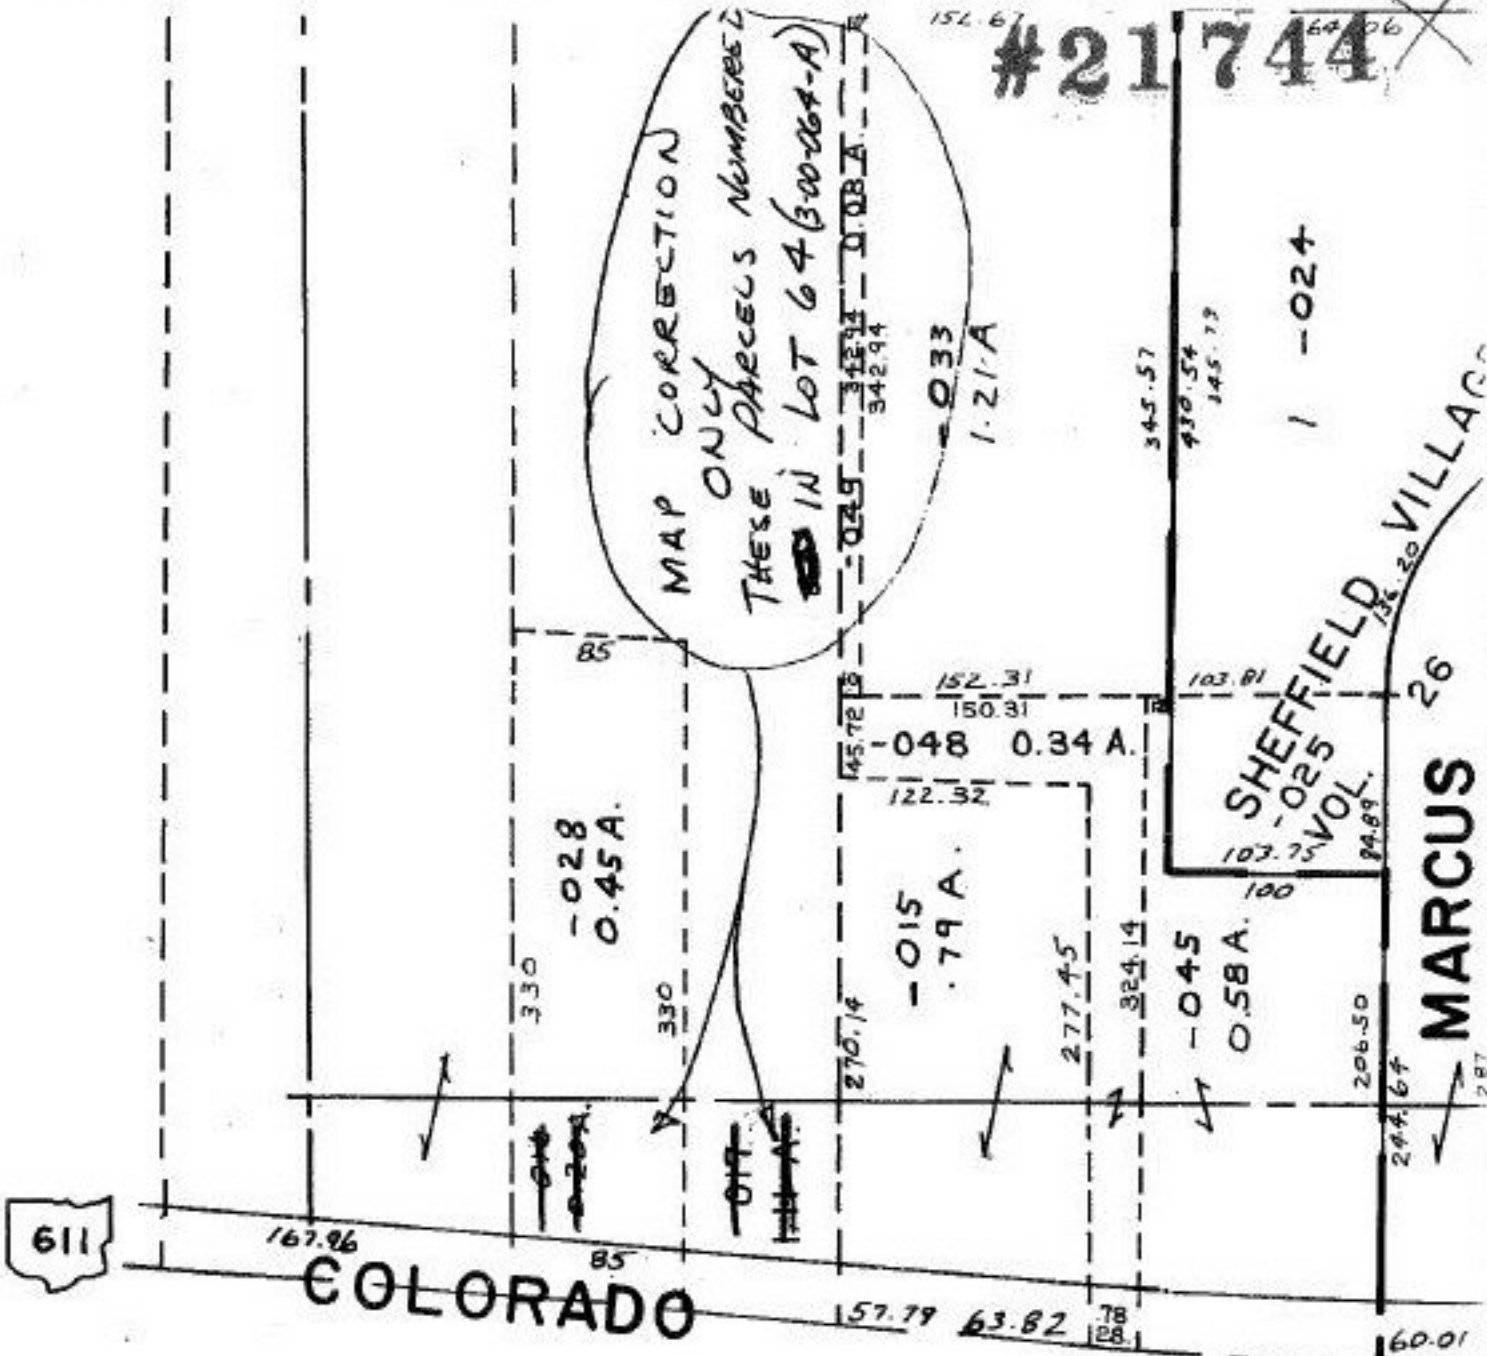

MAP CORRECTION ONLY

#21744-X
SEE

APPROVED
LORAIN CO.
MAP DEPT.
DATE 4-23-97
PAGE 3-00-063
BY R. BELL
VOID AFTER # 21744-X

SHEFFIELD TWP.

SCALE: 1" = 100'