


#21745

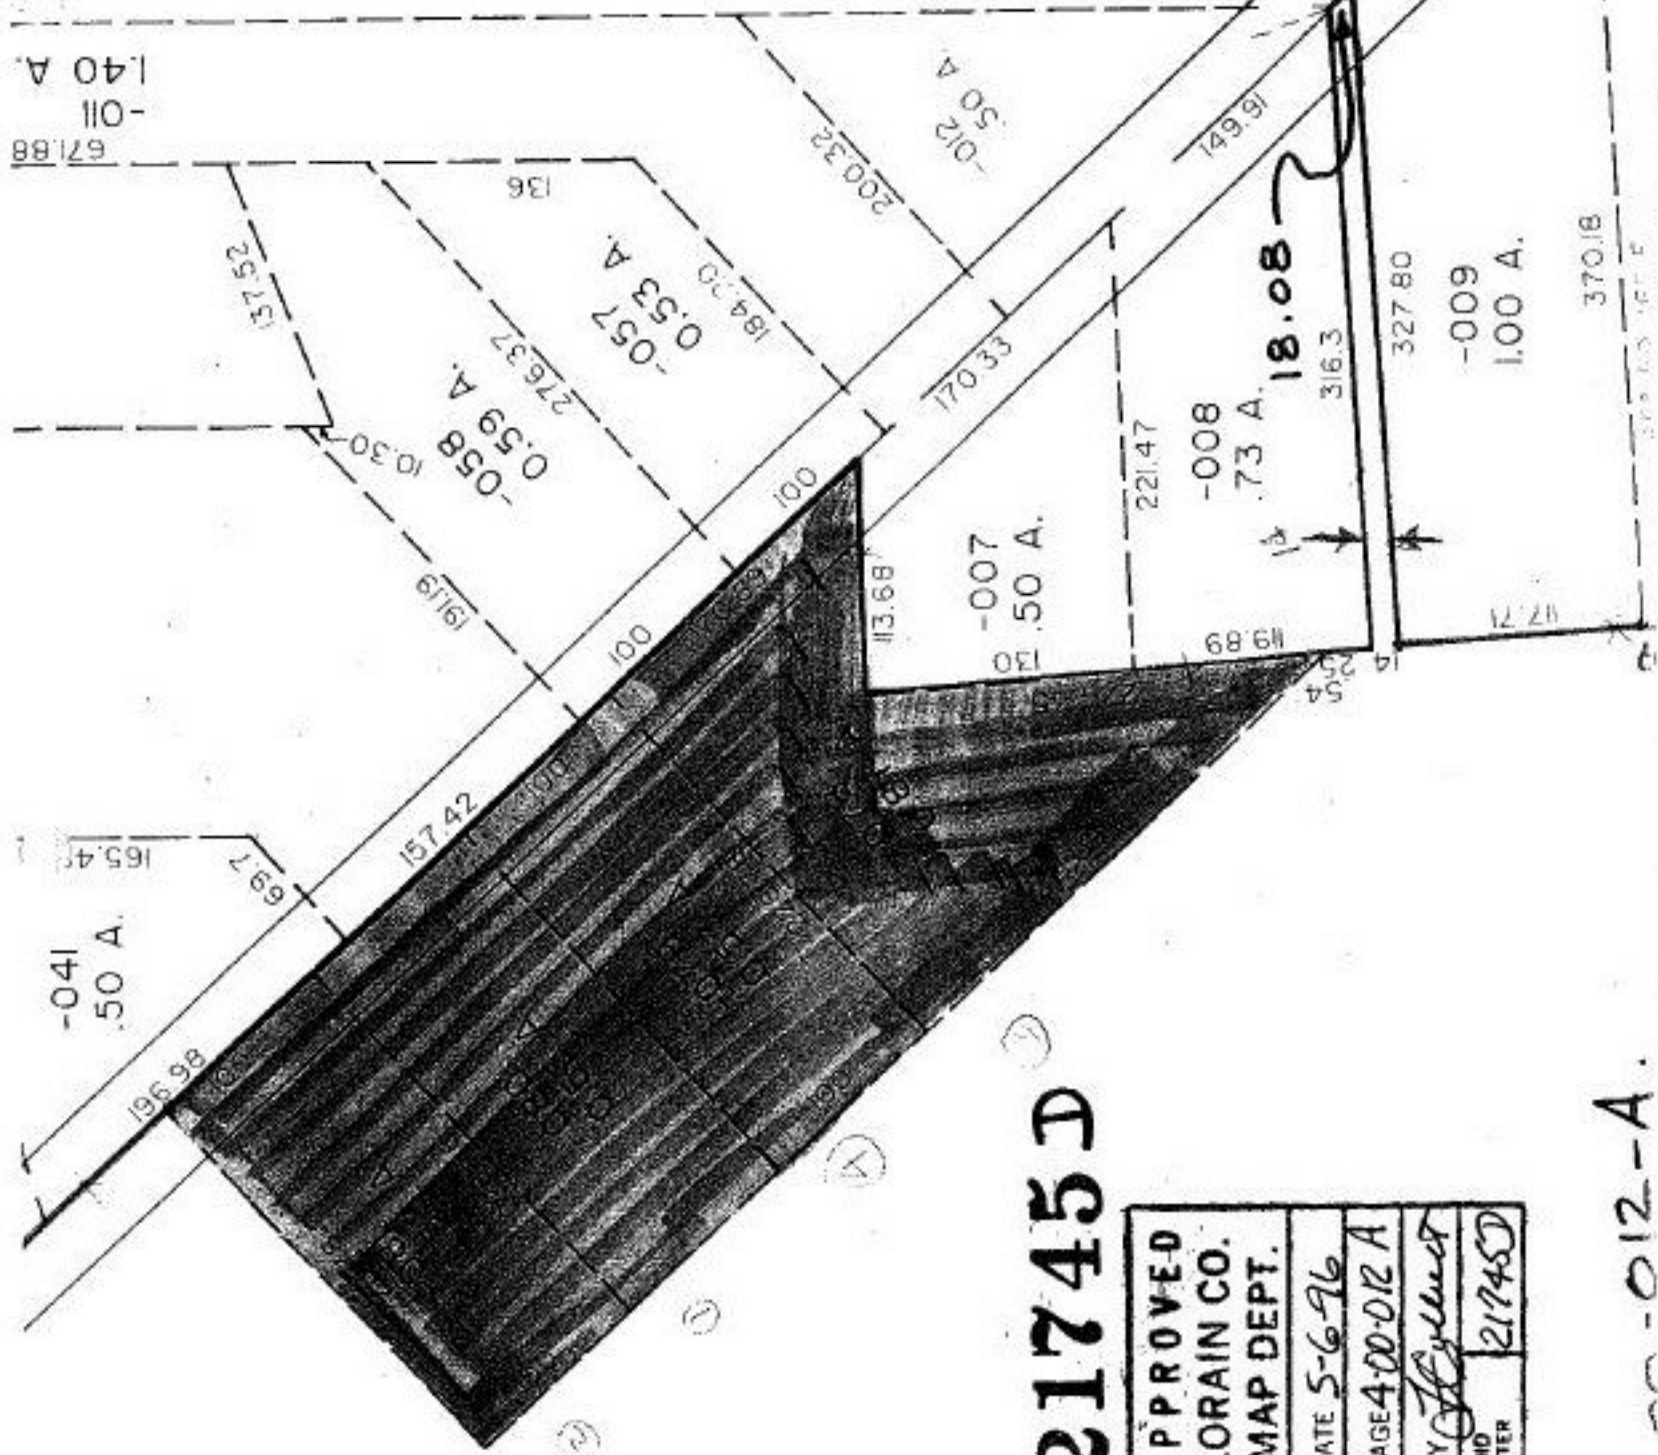

#21745 D

APPROVED	DATE 5-6-96
LORAIN CO.	PAGE 4-00-012 A
MAP DEPT.	BY J. E. [Signature]
VOID AFTER	21745 D

100-012-A

A.