

#21746X

65

ACREAGE  
CORRECTION

Ac. CORRECTED TO: 14-00-076-000-002

From: 2.88 DUP

3.00 TAX MAP

TO: 2.99 Ac. PER Deed O.R. 1245/941

C=1:1000

ASHLAND - OBERLIN

HALLAUER

58

76

459.64  
-007  
3.97 A.

255.21  
-009  
1.34 A.

256.64  
-004  
1.34 A.

338.58  
-002  
1.34 A.


-012  
16.40 A

80334  
WAKEMAN

-005  
17.75 A.

-006  
2.00 A.

303

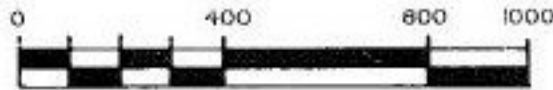

PITTSF

SCALE: 1" = 400'

21746 X

14-C

12-20-95  
REVISED

APPROVED LORAIN CO. MAP DEPT
DATE 4-23-96
PAGE 14-C
BY CAROLYN FRANCIS
# 21746 X