
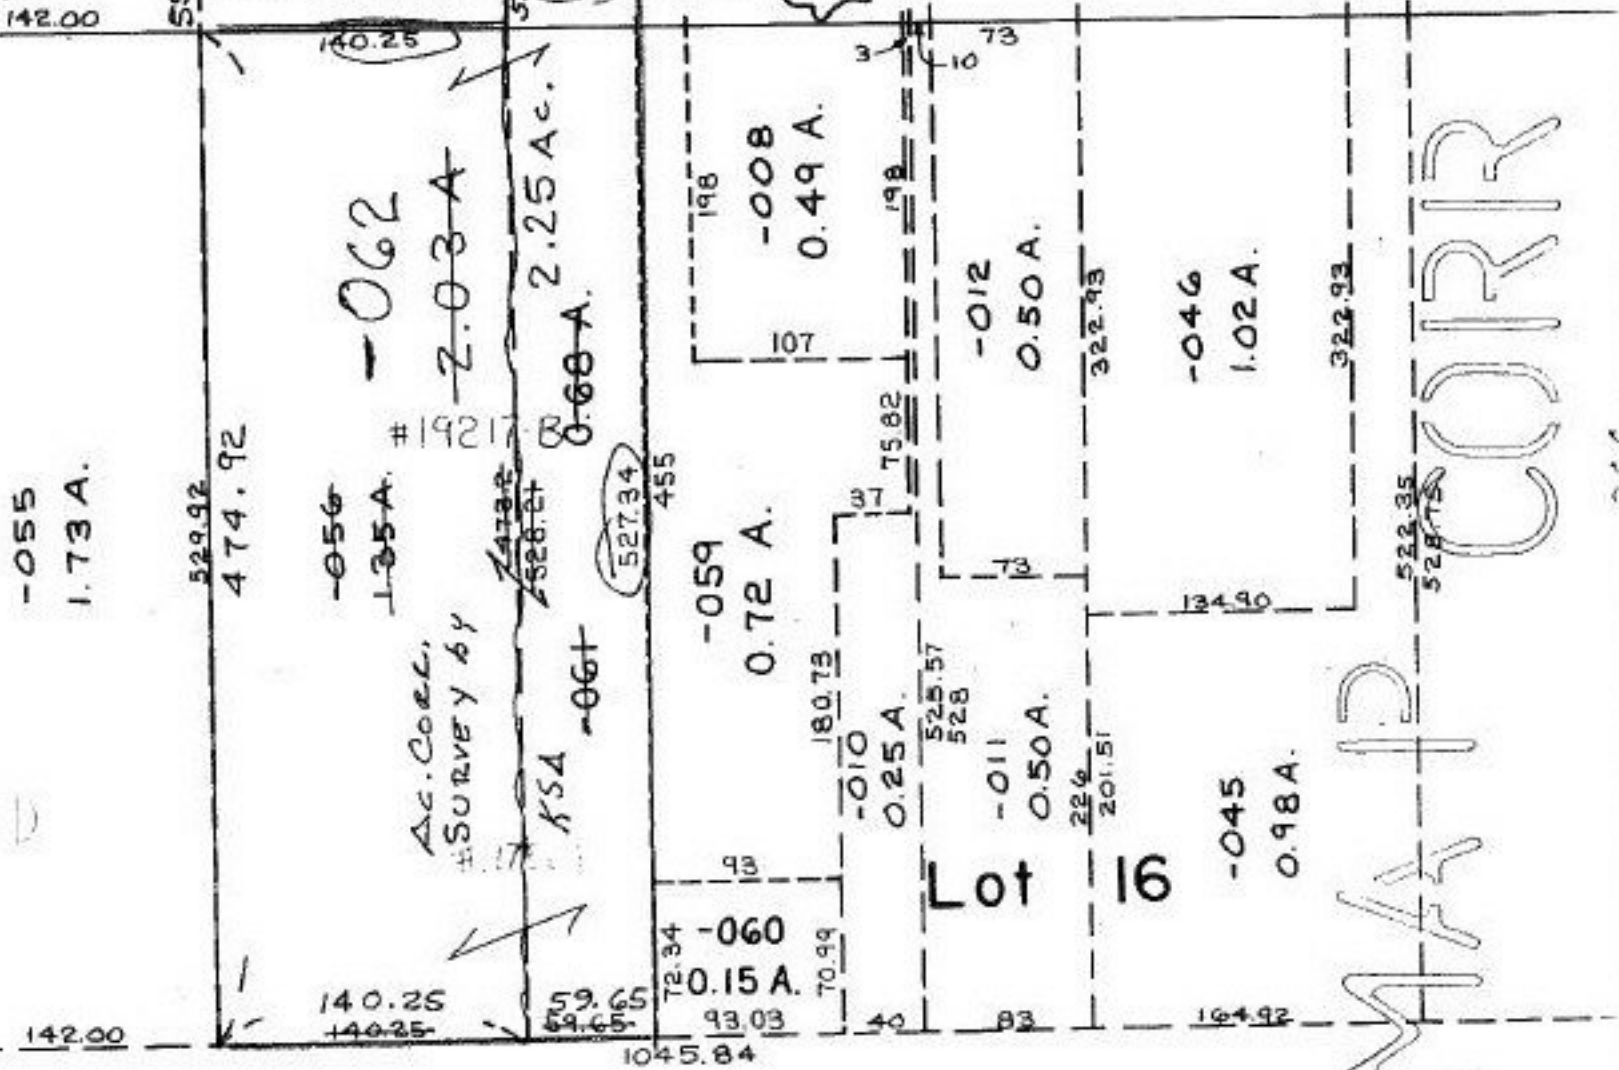


#21752D

SEE 12-00-056-E

R. TWINSBURG

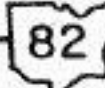

MAR 12 CORR

-057
3.68 A.

21752 D

REFERENCE:

MAP CORRECTION:
COMBINATION & ACREAGES CORRECTION WAS
COMPLETED 12-14-90 BUT WAS NOT PUT ON THE
TAX MAP. #19217-B -058
3.51 A.

COMBINATION AND ACREAGES IS BEING PUT
ON THE TAX MAP WITH #21752-D/

APPROVED
LOHAN CO.
MAP DEPT

DATE 4-30-96

PAGE 12-00-055 B

BY CAROLYN
FRANCIS

21752-D

137.76

521

350