

#21763

-001  
29.20 A.

4044.16

-002  
22.30 A.

6

#21763

3319.33

58


RD. 363  
60

APPROVED	
LORAIN CO.	
MAP DEPT.	
DATE 5-7-96	
PAGE 14-B	
BY K.DYE	
VOID AFTER	21763

-003  
60.00 A.

PRIOR INSTRUMENT \_\_\_\_\_  
CLOSURE \_\_\_\_\_ PER 10,000  
SURVEYED BY \_\_\_\_\_

-006  
35.20 A.

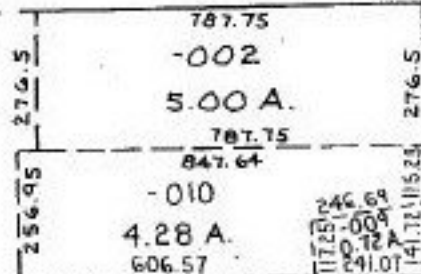

-003  
0.80 A.

15

-012  
~~-008~~  
42.07 A.  
39.92 A.



-011  
2.15 A.

RD

20

316.22 460

(120' Variable)

43.70 235.07 593.47 209.97 4.15

-011  
3.62 A.

492.94

-014  
5.21 A.

492.97

-002  
11.00 A.

460

-009  
8.30 A.

495.84

-006  
1.70 A.

495.84

29.45