




#21767-D

Pt. -036
Pt. 42.13

SEE 1-00-027-B

DEED
CHECK

NO CHANGES
OF TAX MAP
PT OF
PARCEL 2,3

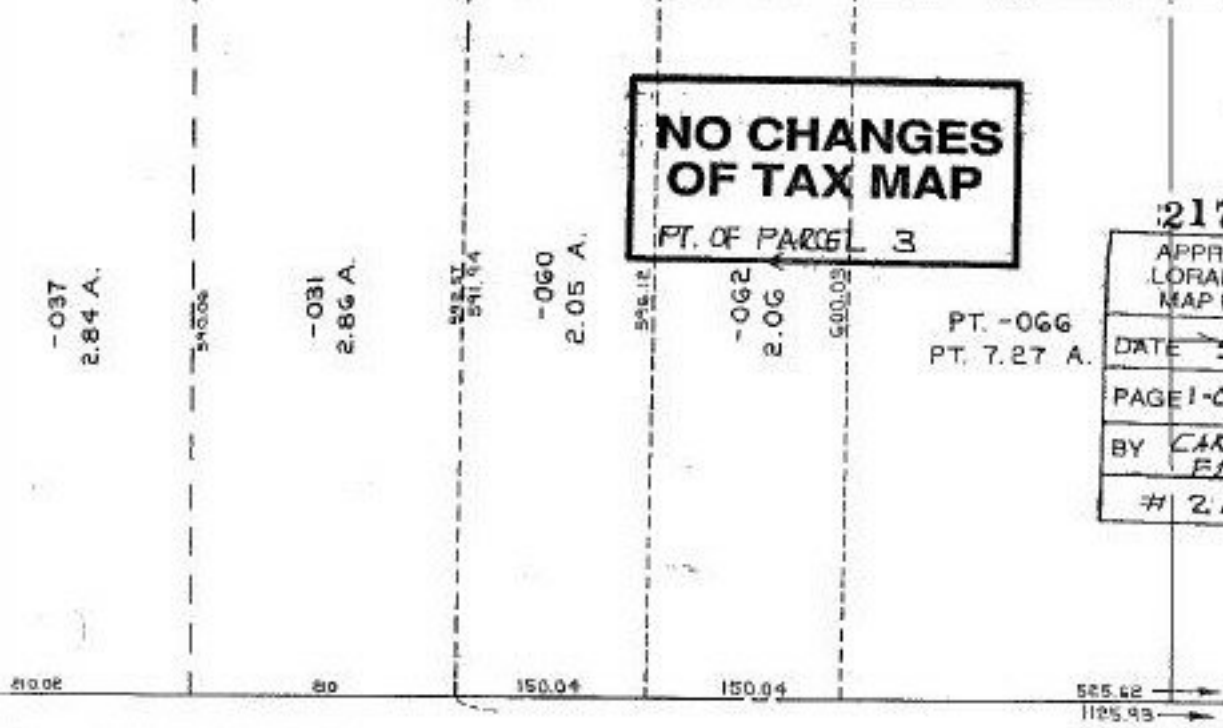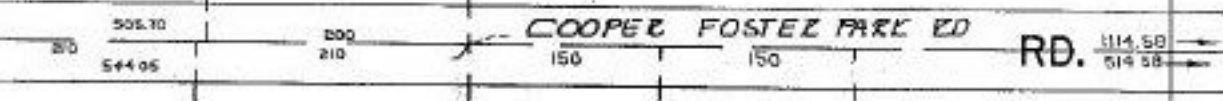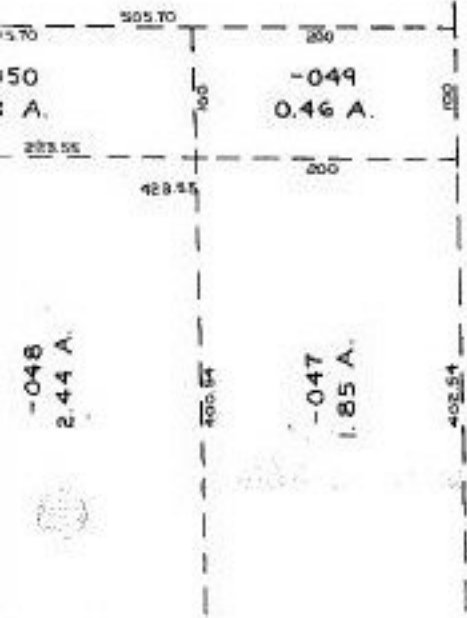

NO CHANGES
OF TAX MAP
PT. OF PARCEL 3

PT. -066
PT. 7.27 A.

21767-D

APPROVED LORAIN CO. MAP DEPT
DATE 5-9-96
PAGE 1-00-027A
BY CAROLYN FRACKLE
21767D

SEE 1-00-038-A

1-00-027-A