

#21767²⁵⁷³⁰ SEE D

104

DEED
CHECK


Pr. - 029
Pr. 38.54 A.

NO CHANGES
OF TAX MAP
PART OF
PARCEL 1

21767-D

| |
|------------------------------------|
| APPROVED LORAIN CO. MAP DEPT |
| DATE 5-9-96 |
| PAGE 1-00-022-A |
| BY CAROLYN FRANCIS |
| 21767 |

NEED EXCEPTION FOR

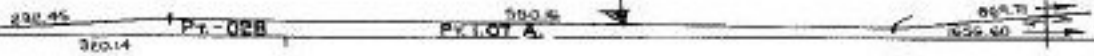

SEE 1-00-027-A