


21768

APPROVED
 LORAIN W.
 MAP DEPT.
 DATE 5-8-96
 PAGE 9-00-095-B
 BY K. DYE
 VOND AFTER # 21768

SFF 9-00-095-A

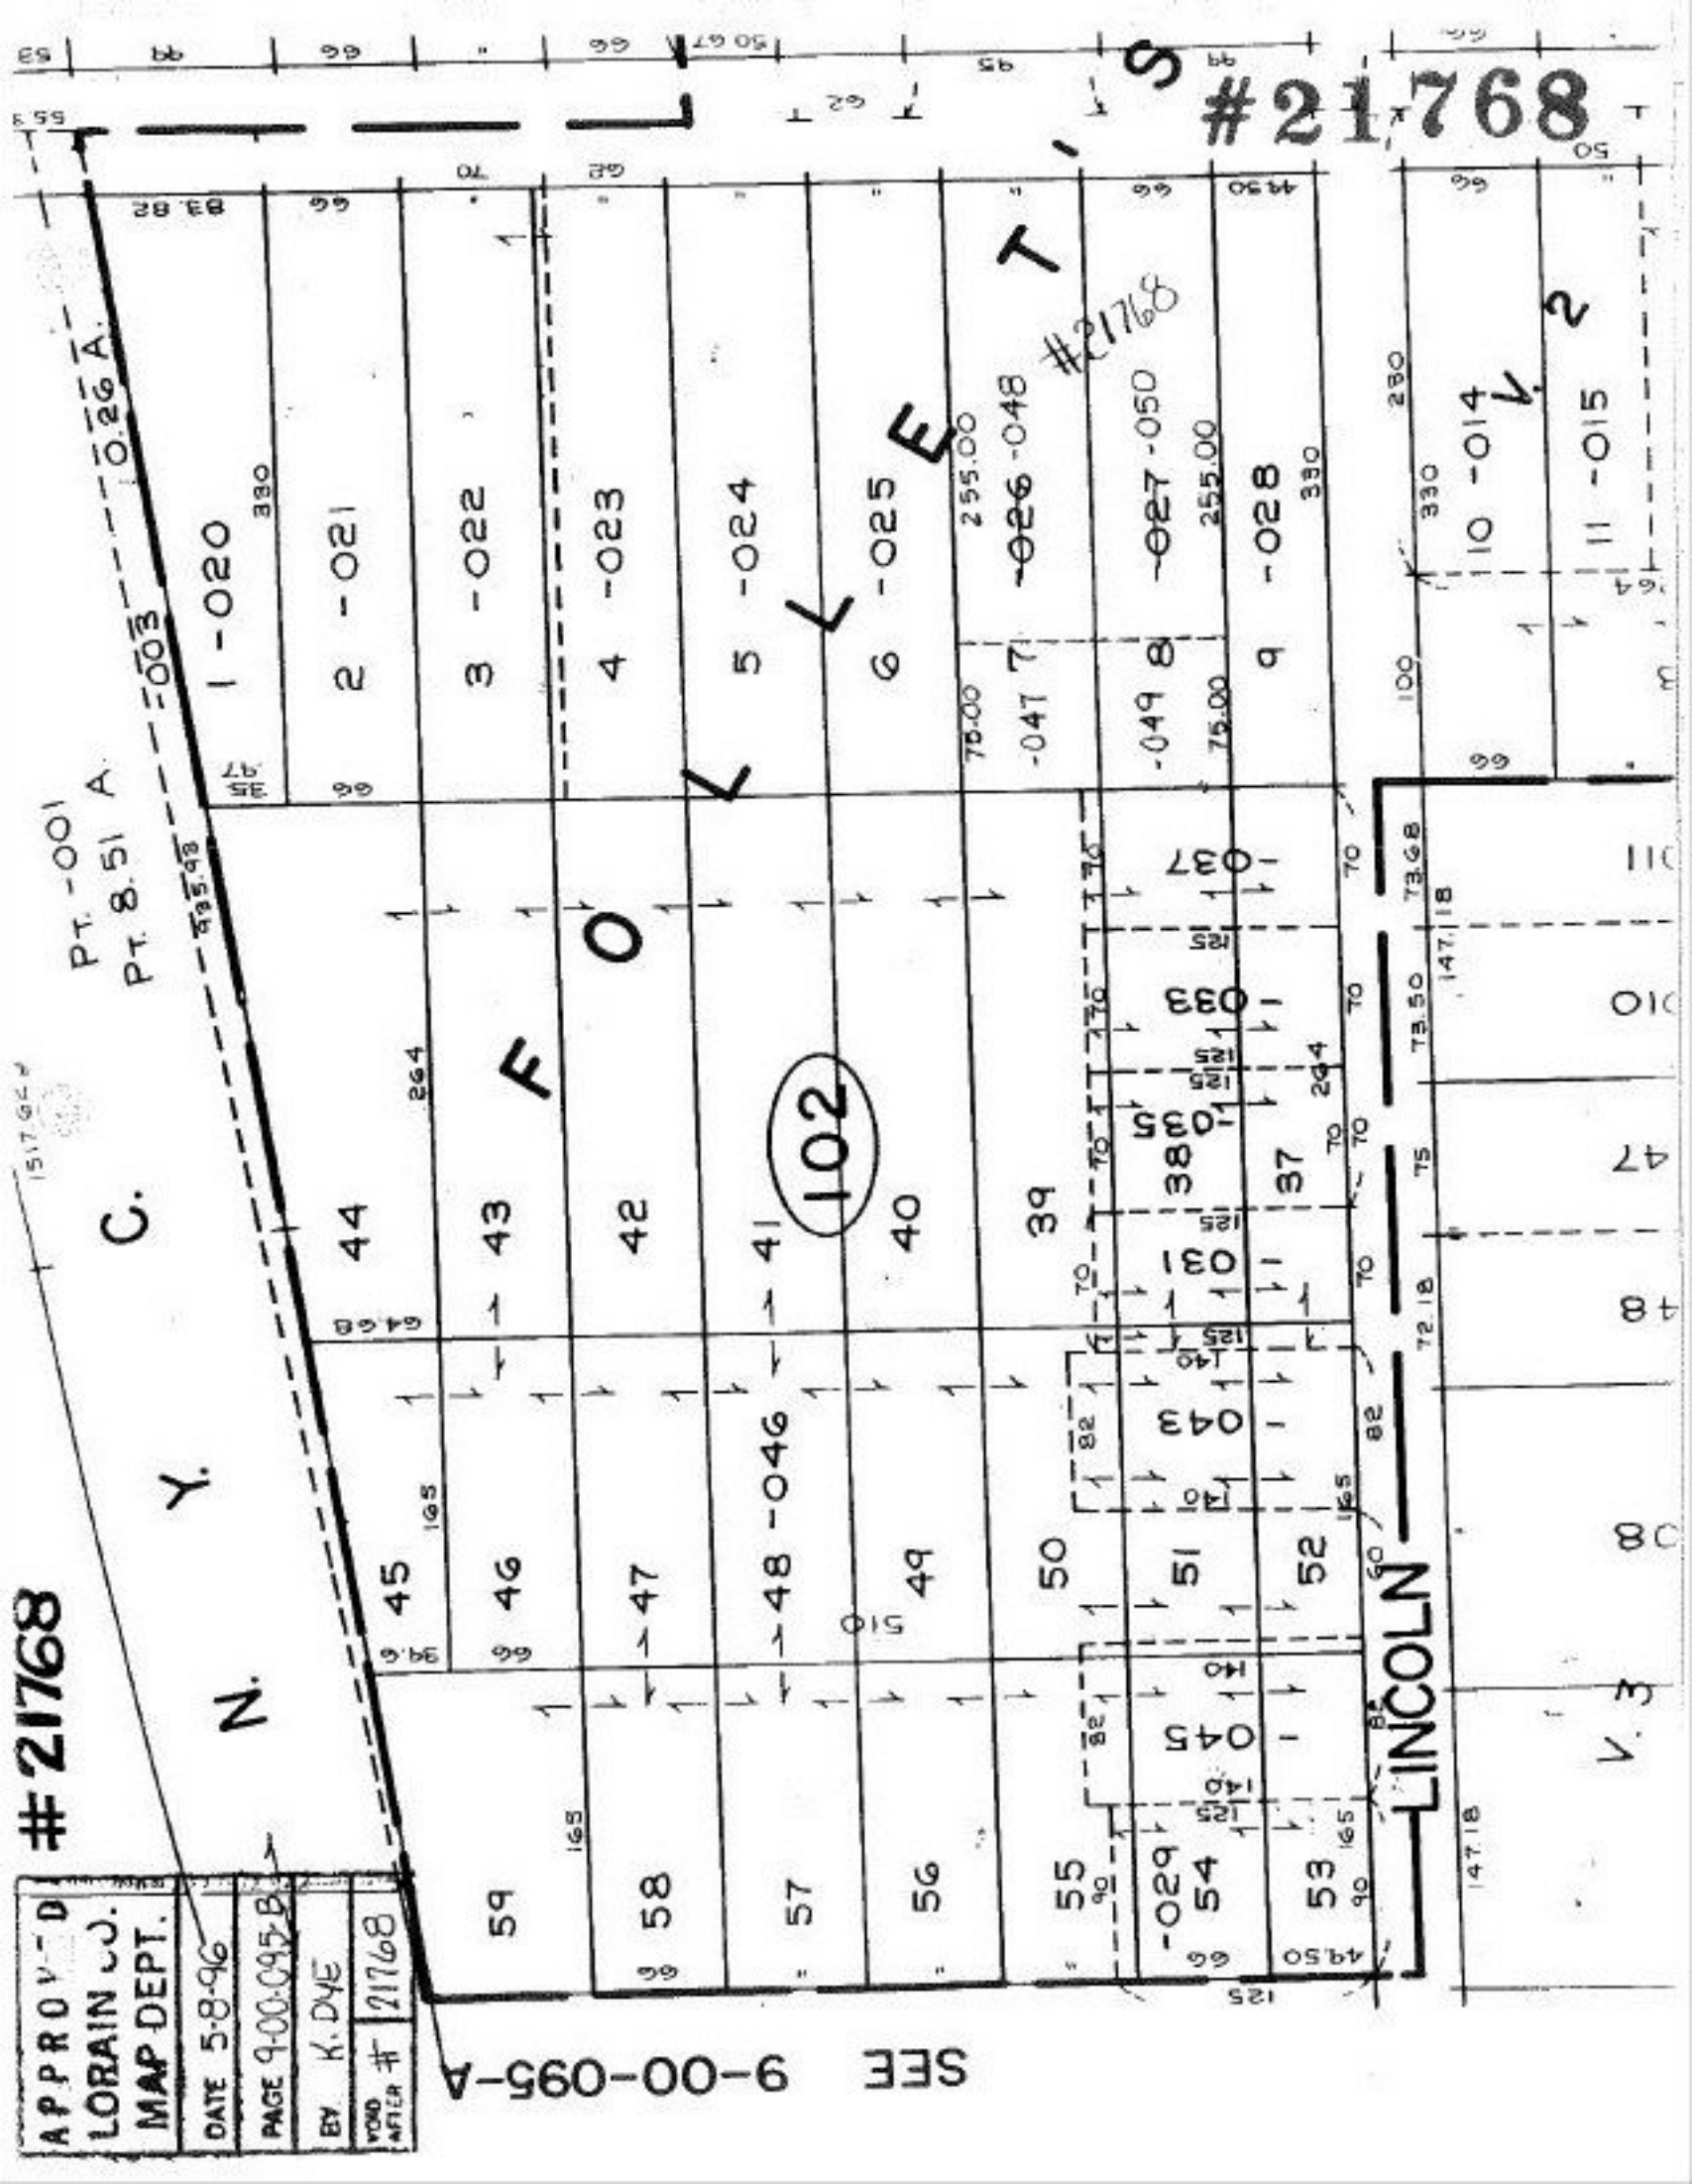

21768

LINCOLN

V. 3

2

10 - 014

11 - 015

100 330 250

73.50 73.68

75

72.18

70

70

70

147.18

147.18

