


~~15.02A~~
~~15.10-12A~~
-054
15.05A

-029
10.00A.

101

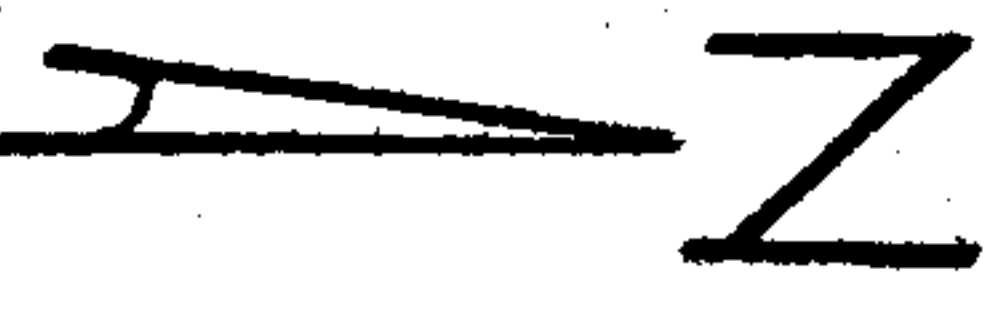

CHESTER

SERVICE

INTERSTATE

CHESTER

2177

137.52 150 70 30

365.85
-053
.584 AC
311.60

54.73 30 30

300.4

1365.07

368.15

330.10

1951.00

APPROVED
LORAIN CO.
MAP DEPT.
DATE 10/17/68
BY R.L. Kallins

(Handwritten signature)

1968-21