



#21770-D

PARENT PARCEL: 02-02-002-000-070, 02-02-003-101-043

CHILD PARCEL: N/A

STARTING POINT: CL COOPER FOSTER PARK RD. & CL LEAVITT RD.

NO. 21770-D

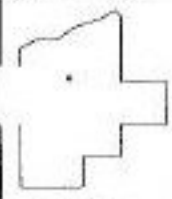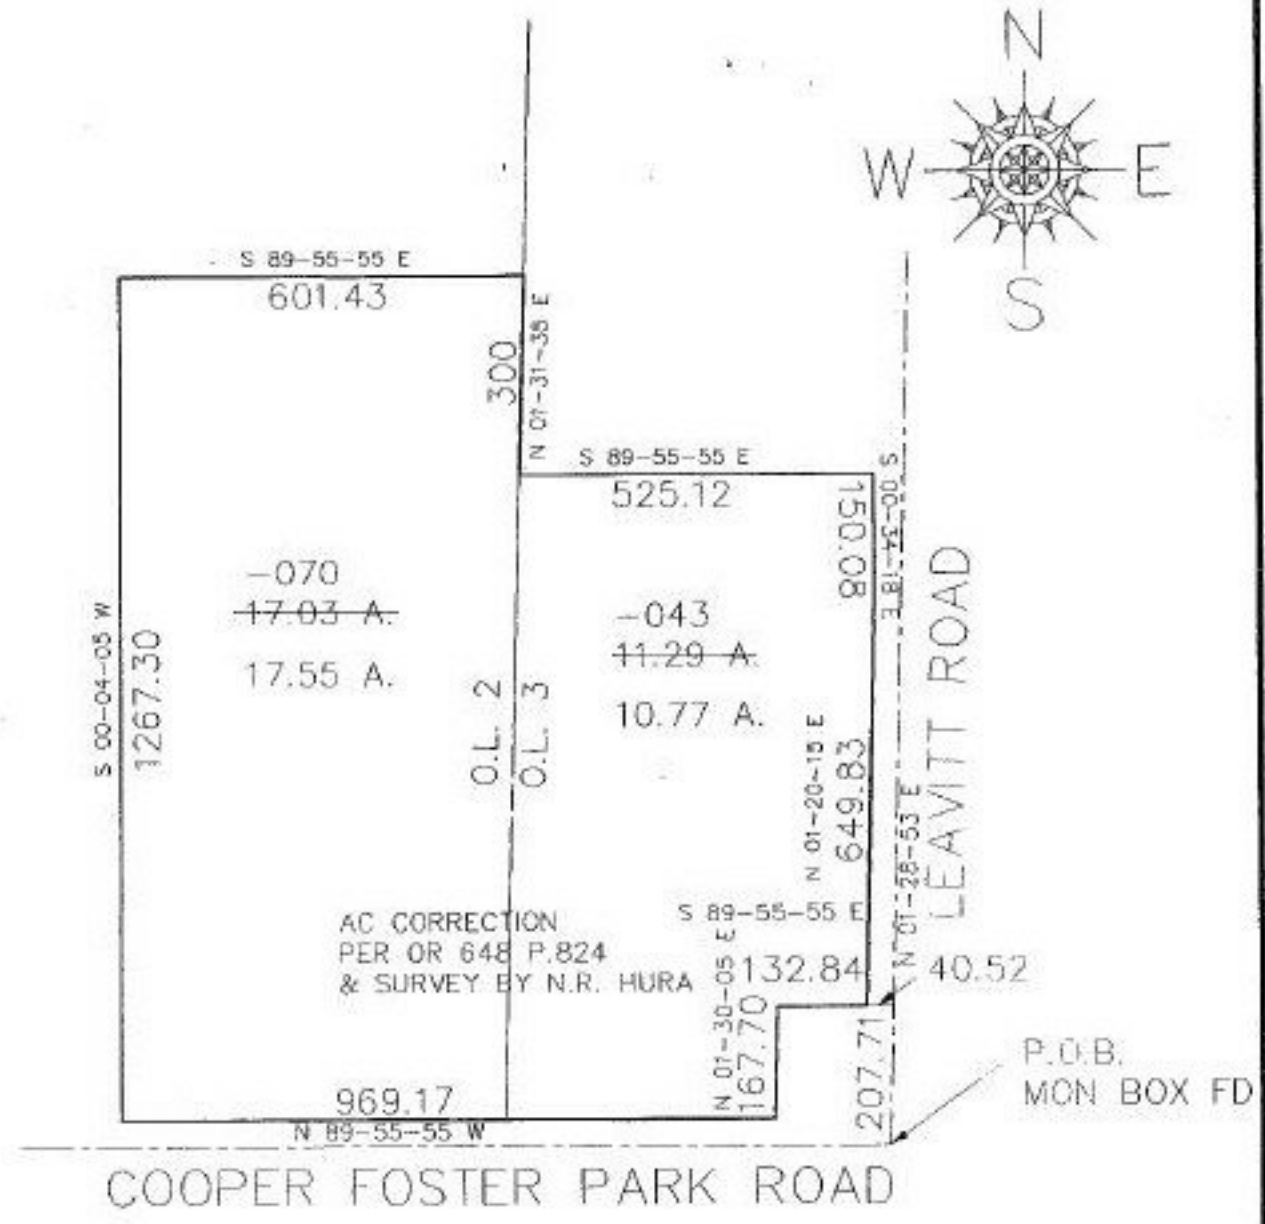

**SPLITS/DEEDS PROCESSED**  
 LORAIN COUNTY TAX MAP DEPARTMENT  
 228 MIDDLE AVE. ELYRIA, OHIO

SURVEYED BY: N.R. HURA  
 CLOSURE: 0.03 : 10.000  
 MAP PAGE(S): 02-02-003, 02-02-002-B  
 APPROVED BY: KAC/RFB DATE: 4-11-97  
 SCALE: 1" = 300'