


APPROVED
LORAIN CO.
MAP DEPT.
DATE 5-9-96
PAGE 4-00-013-E,F
BY K.DYE
21774-A

#21774-A

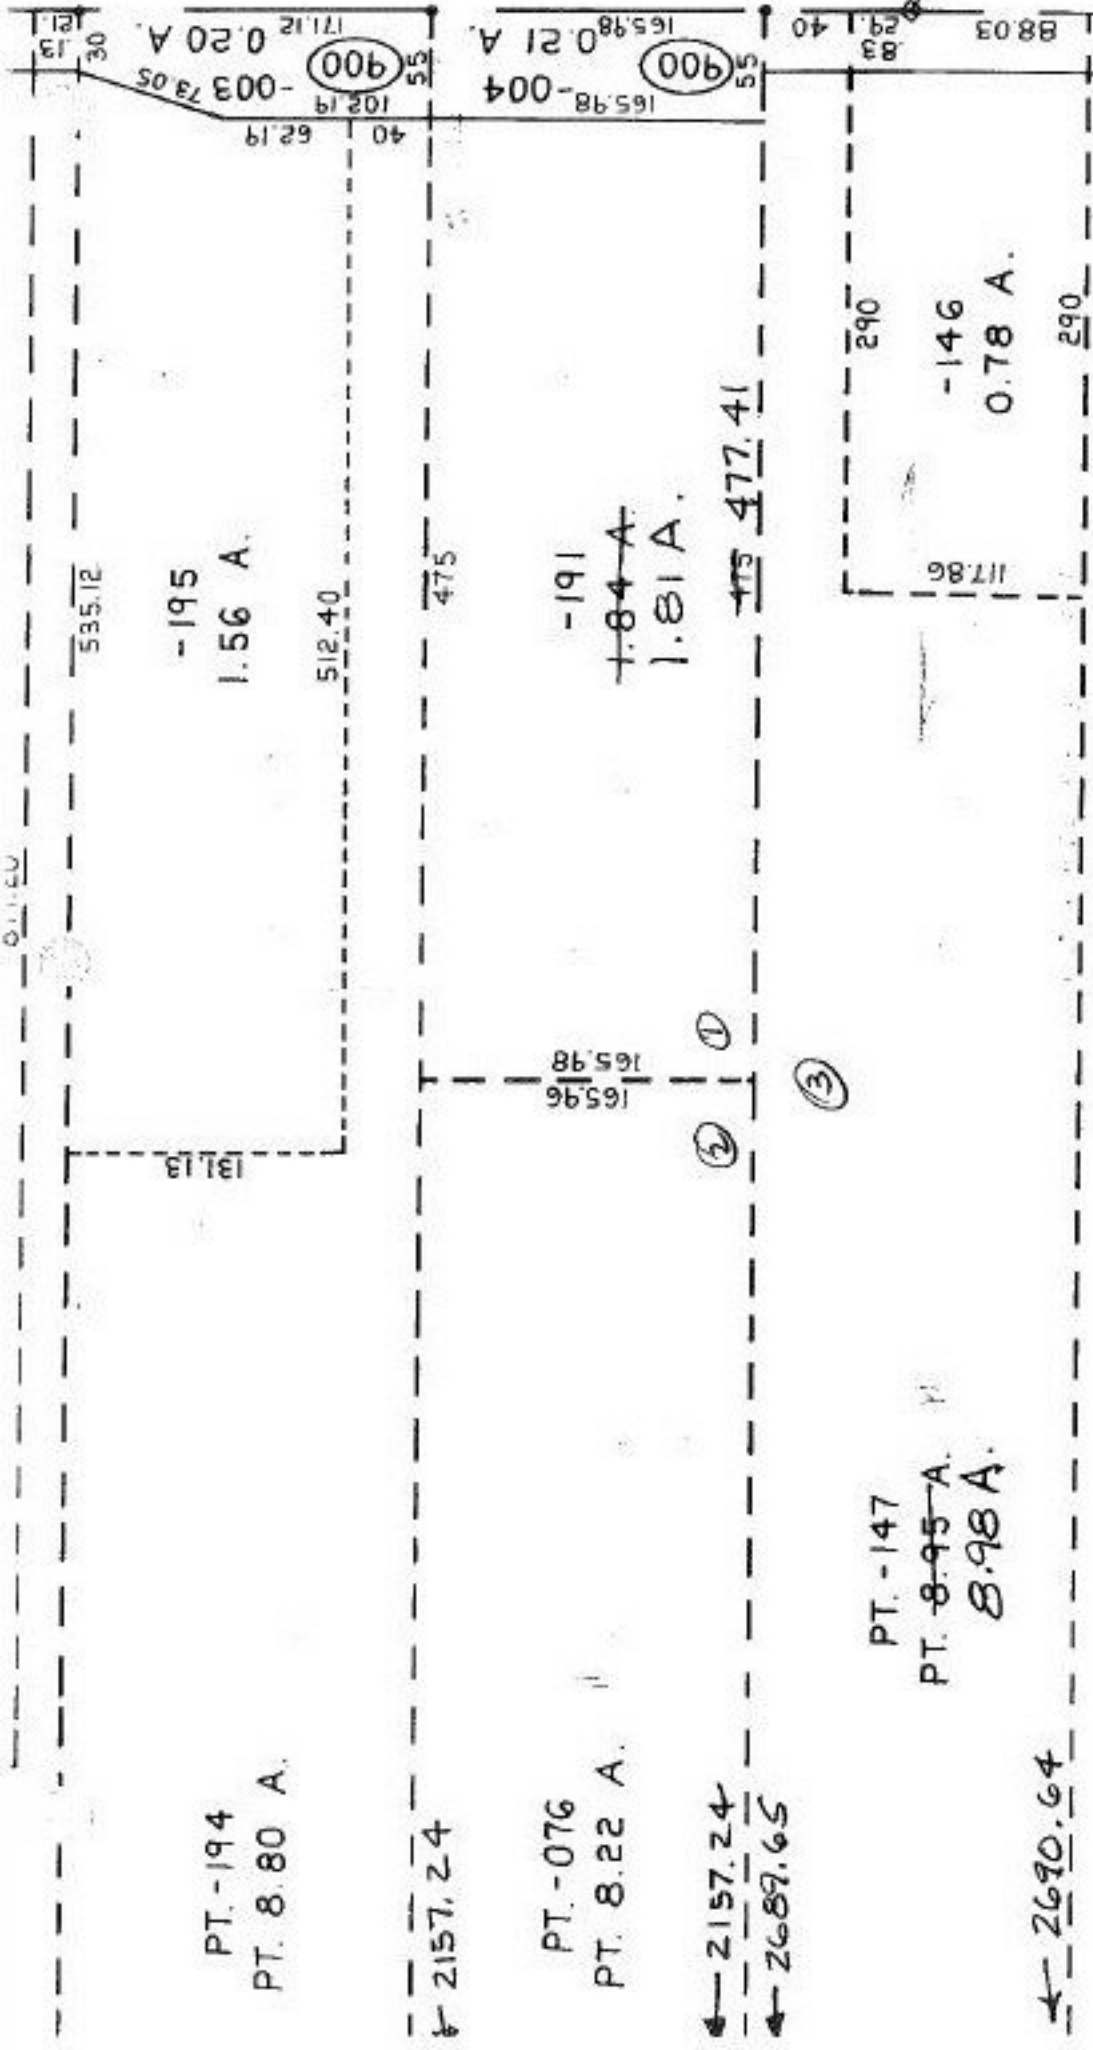

PT. -194
PT. 8.80 A.

PT. 2157.24

PT. -076
PT. 8.22 A.

PT. 2157.24
PT. 2689.65

PT. -147
PT. 8.95 A.
PT. 8.98 A.

PT. 2690.64

PT. -036
PT. 20.00 A.

12-F