


FILE

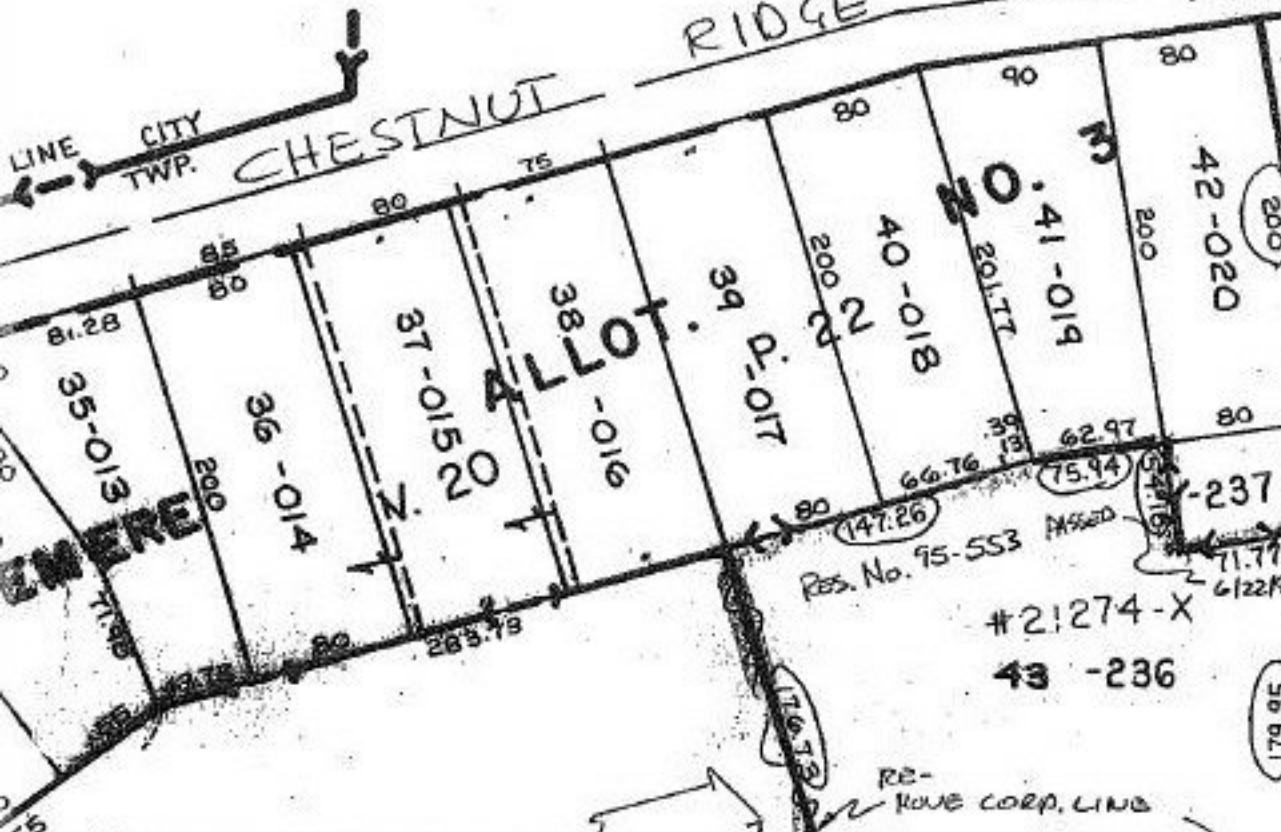

NOT CHANGES
 NOT TAX MAP

RES. No. 95-553
PASSED 6/22/95

21776-X
 APPROVED
 LORAIN CO.
 MAP DEPT
 DATE 5-22-96
 PAGE 10-00-005E
 BY CAROLYN FRANCIS
 21776X

P.P. No.
Change TO

107

~~10-00-005-101-236~~

SHOULD BE:

10-00-005-107-236

CORR. DUP. TRANSFER SHT.
ONLY

Pt. - 140
Pt. 15.00 A.

ANNEXATION

#21274-X
 APPROVED
 LORAIN CO.
 MAP DEPT.
 DATE 3/13/96
 PAGE 10-00-005-E
 BY T. McNeil
 VOID AFTER 21274-X