


#21781  
R.1



E 15-00-065-B

P.P.NO. 15-00-056-000  
 15-00-065-000  
 PRIOR INST: O.R.861/367

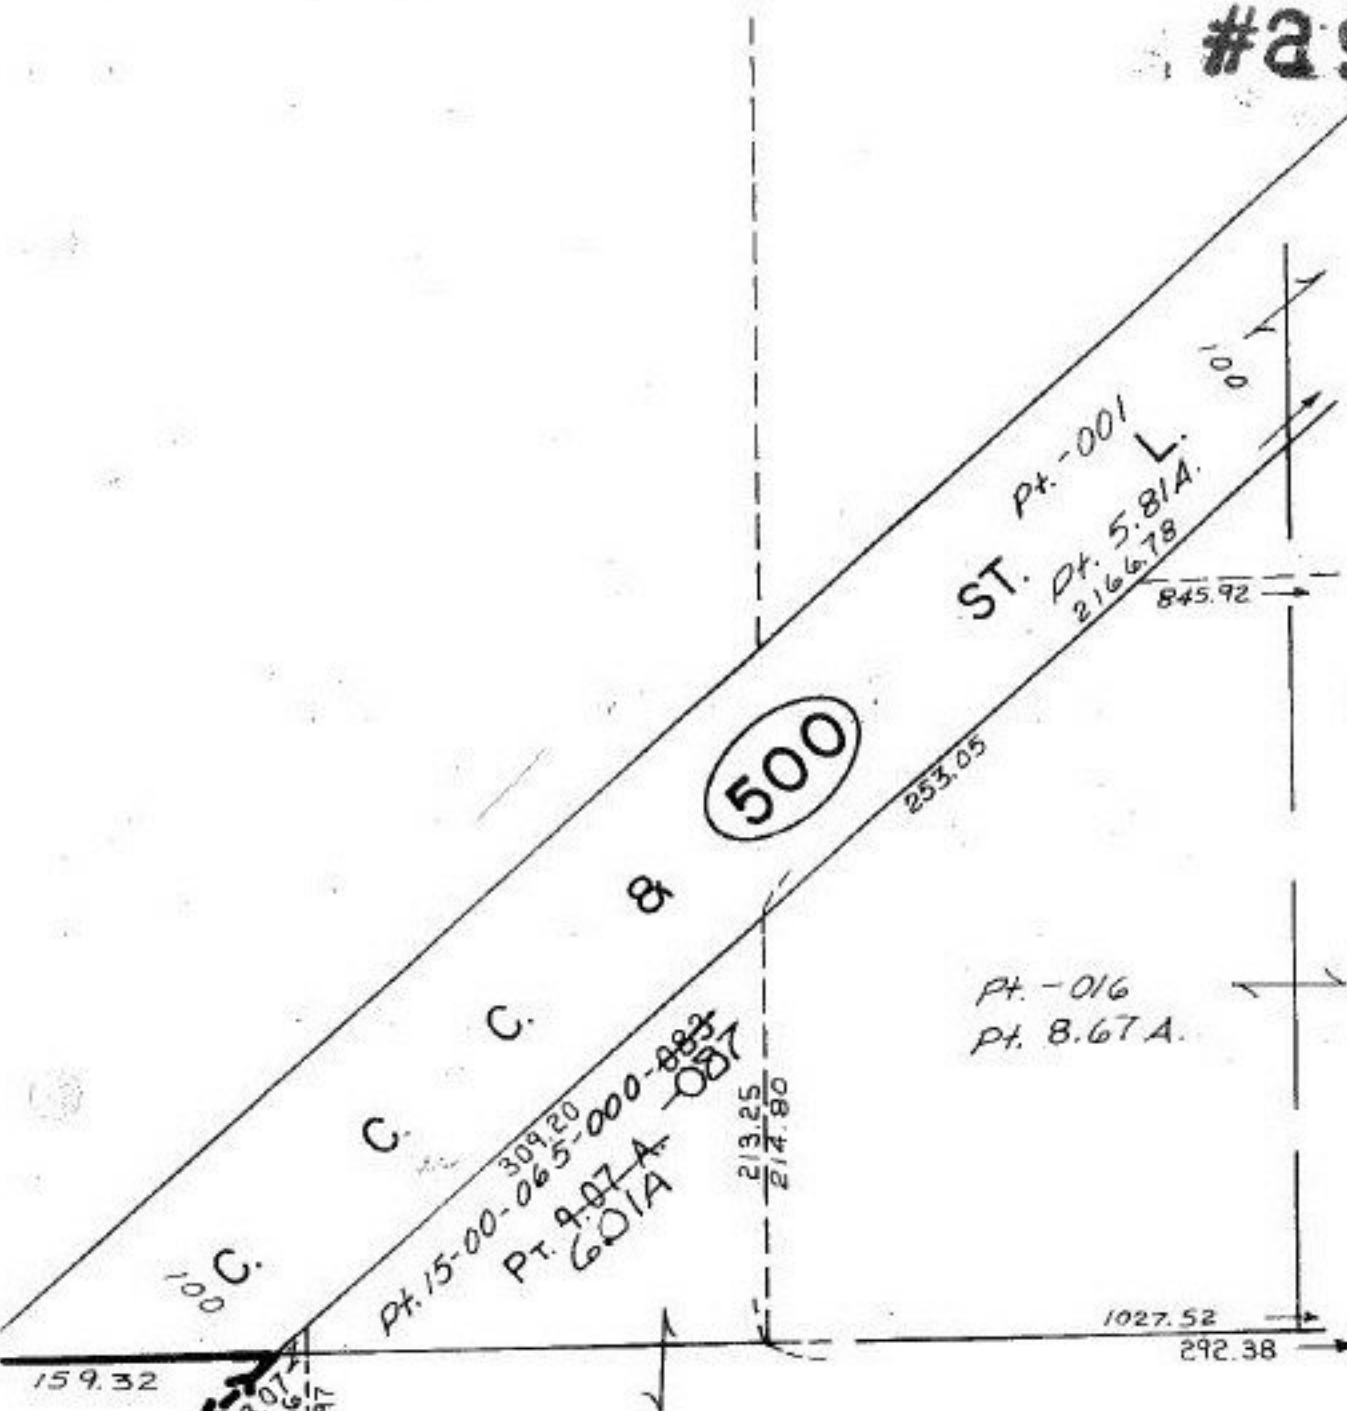

21781  
 APPROVED  
 LORAIN CO.  
 MAP DEPT  
 DATE 5-31-96  
 PAGE 15-00-056-A  
 BY CAROLYN  
 FRANCLIS  
 # 21781

# LAGRANGE TWP.

SCALE: 1" = 100'