

COMBINATION

SEE 21-17-010-A

309.00

- 014
Pl. -002
Pl. 4499A
44.99A

61.755

1955.58

- 013
-001
-0-61A
8.50 A

SPLIT

21783

APPROVED
LORAIN CO.
MAP DEPT.
DATE 6-3-96
PAGE 21-17-011A
BY CAROLYN FRANCIS
21783

P.P. NO. 21-17-010-000
 21-17-011-000
 PRIOR INSTR: C.R. 353/5540 (002)
 C.R. 353/598 (002)(003)
 SPLIT CLOSURE: 1.2, 1.1 RT.
 SURVEYED BY: JOHN FRIEDMAN R.S.


21783

APPROVED
LORAIN CO.
MAP DEPT.
DATE 6-3-96
PAGE 21-17-000
BY CAROLYN FRANCIS
21783

COMB. 21-17-010-000-027
21-17-011-000-002

21783

2

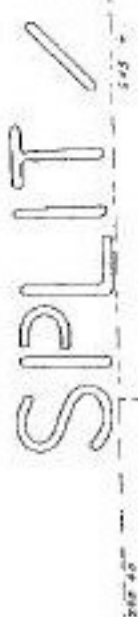

APPROVED
LORAIN CO.
MAP DEPT.
DATE 6-3-96
PAGE 21-17-011A
BY CAROLYN FRANCIS
21783

P.P. NO. 21-17-010-000
 21-17-011-000
 PRIOR INSTR: C.R. 353/5540 (002)
 C.R. 353/598 (002)(003)
 SPLIT CLOSURE: 1.2, 1.1 RT.
 SURVEYED BY: JOHN FRIEDMAN R.S.

21783

APPROVED
LORAIN CO.
MAP DEPT.
DATE 6-3-96
PAGE 21-17-000
BY CAROLYN FRANCIS
21783

COMB. 21-17-010-000-027
21-17-011-000-002

21783

2



APPROVED
LORAIN CO.
MAP DEPT.
DATE 6-3-96
PAGE 21-17-011A
BY CAROLYN FRANCIS
21783

P.P. NO. 21-17-010-000
 21-17-011-000
 PRIOR INSTR: C.R. 353/5540 (002)
 C.R. 353/598 (002)(003)
 SPLIT CLOSURE: 1.2, 1.1 RT.
 SURVEYED BY: JOHN FRIEDMAN R.S.