


#21794

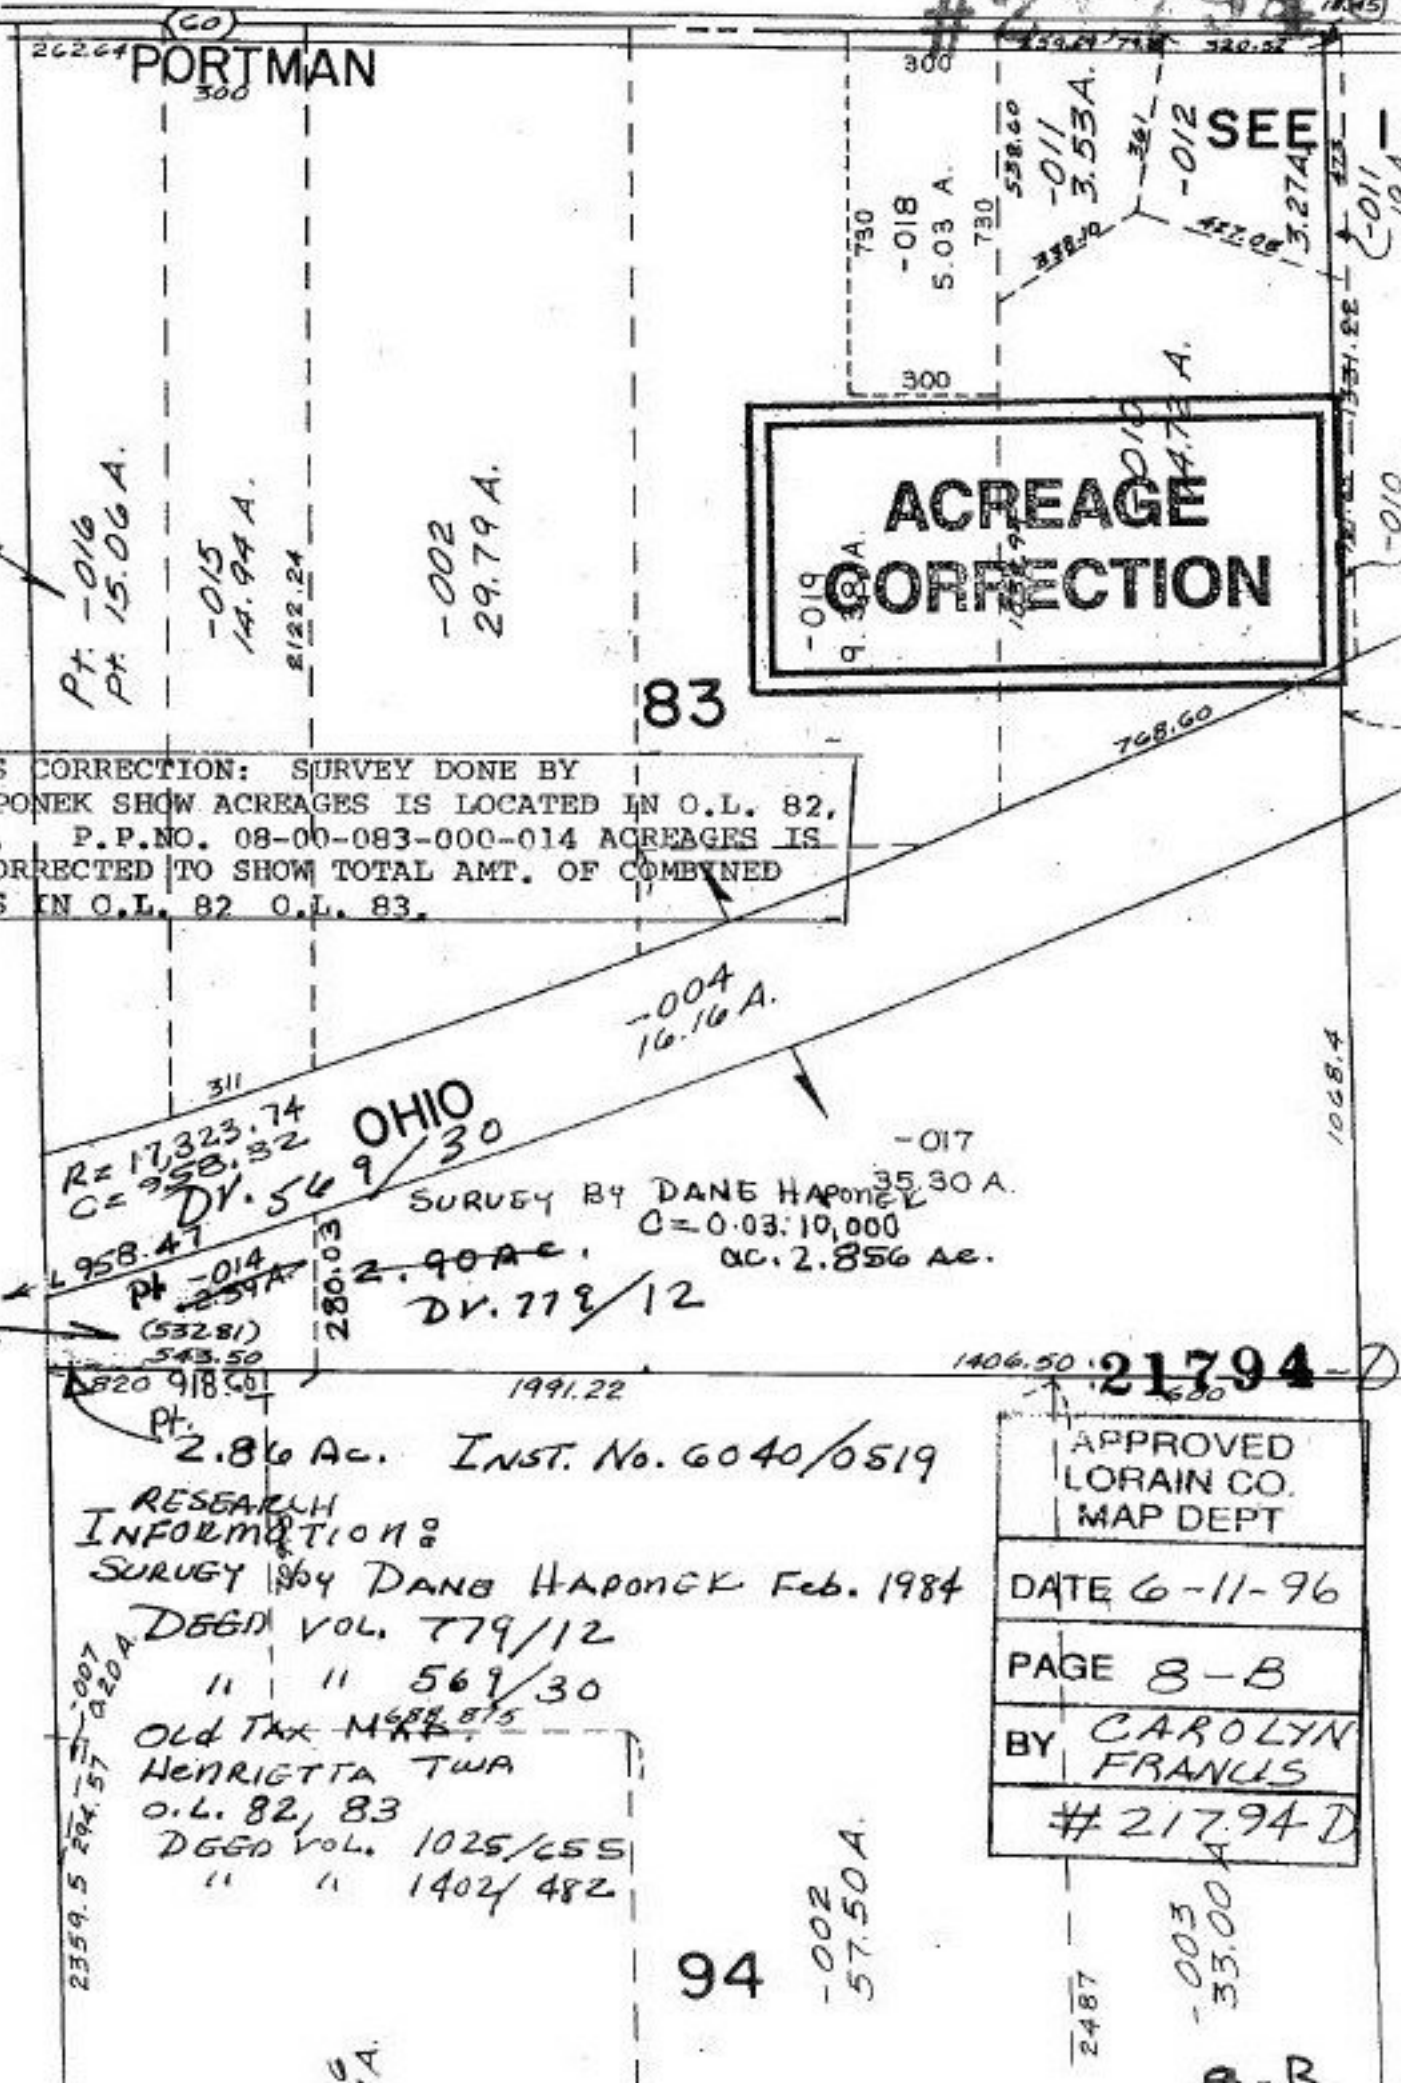

ACREAGE CORRECTION

ACREAGES CORRECTION: SURVEY DONE BY DANE HAPONEK SHOW ACREAGES IS LOCATED IN O.L. 82, O.L. 83. P.P.NO. 08-00-083-000-014 ACREAGES IS BEING CORRECTED TO SHOW TOTAL AMT. OF COMBINED ACREAGES IN O.L. 82 O.L. 83.

OHIO
 R=17,323.74
 C=958.32
 DV. 569/30
 SURVEY BY DANE HAPONEK
 C=0.03:10,000
 AC. 2.856 Ac.
 Pt. -014
 2.59 A.
 (53281)
 543.50
 820 918.50
 Pt. 2.86 Ac.
 1991.22
 1406.50

INST. No. 6040/0519
 RESEARCH INFORMATION:
 SURVEY BY DANE HAPONEK Feb. 1984
 DGGD VOL. 779/12
 " " 569/30
 OLD TAX MAP 688,875
 HENRIETTA TWA
 O.L. 82, 83
 DGGD VOL. 1025/655
 " " 1402/482

APPROVED
 LORAIN CO.
 MAP DEPT
 DATE 6-11-96
 PAGE 8-B
 BY CAROLYN
 FRANKS
 #21794 D

94

-002
57.50 A.

-003
33.00 A.

A-R