


#21798-D

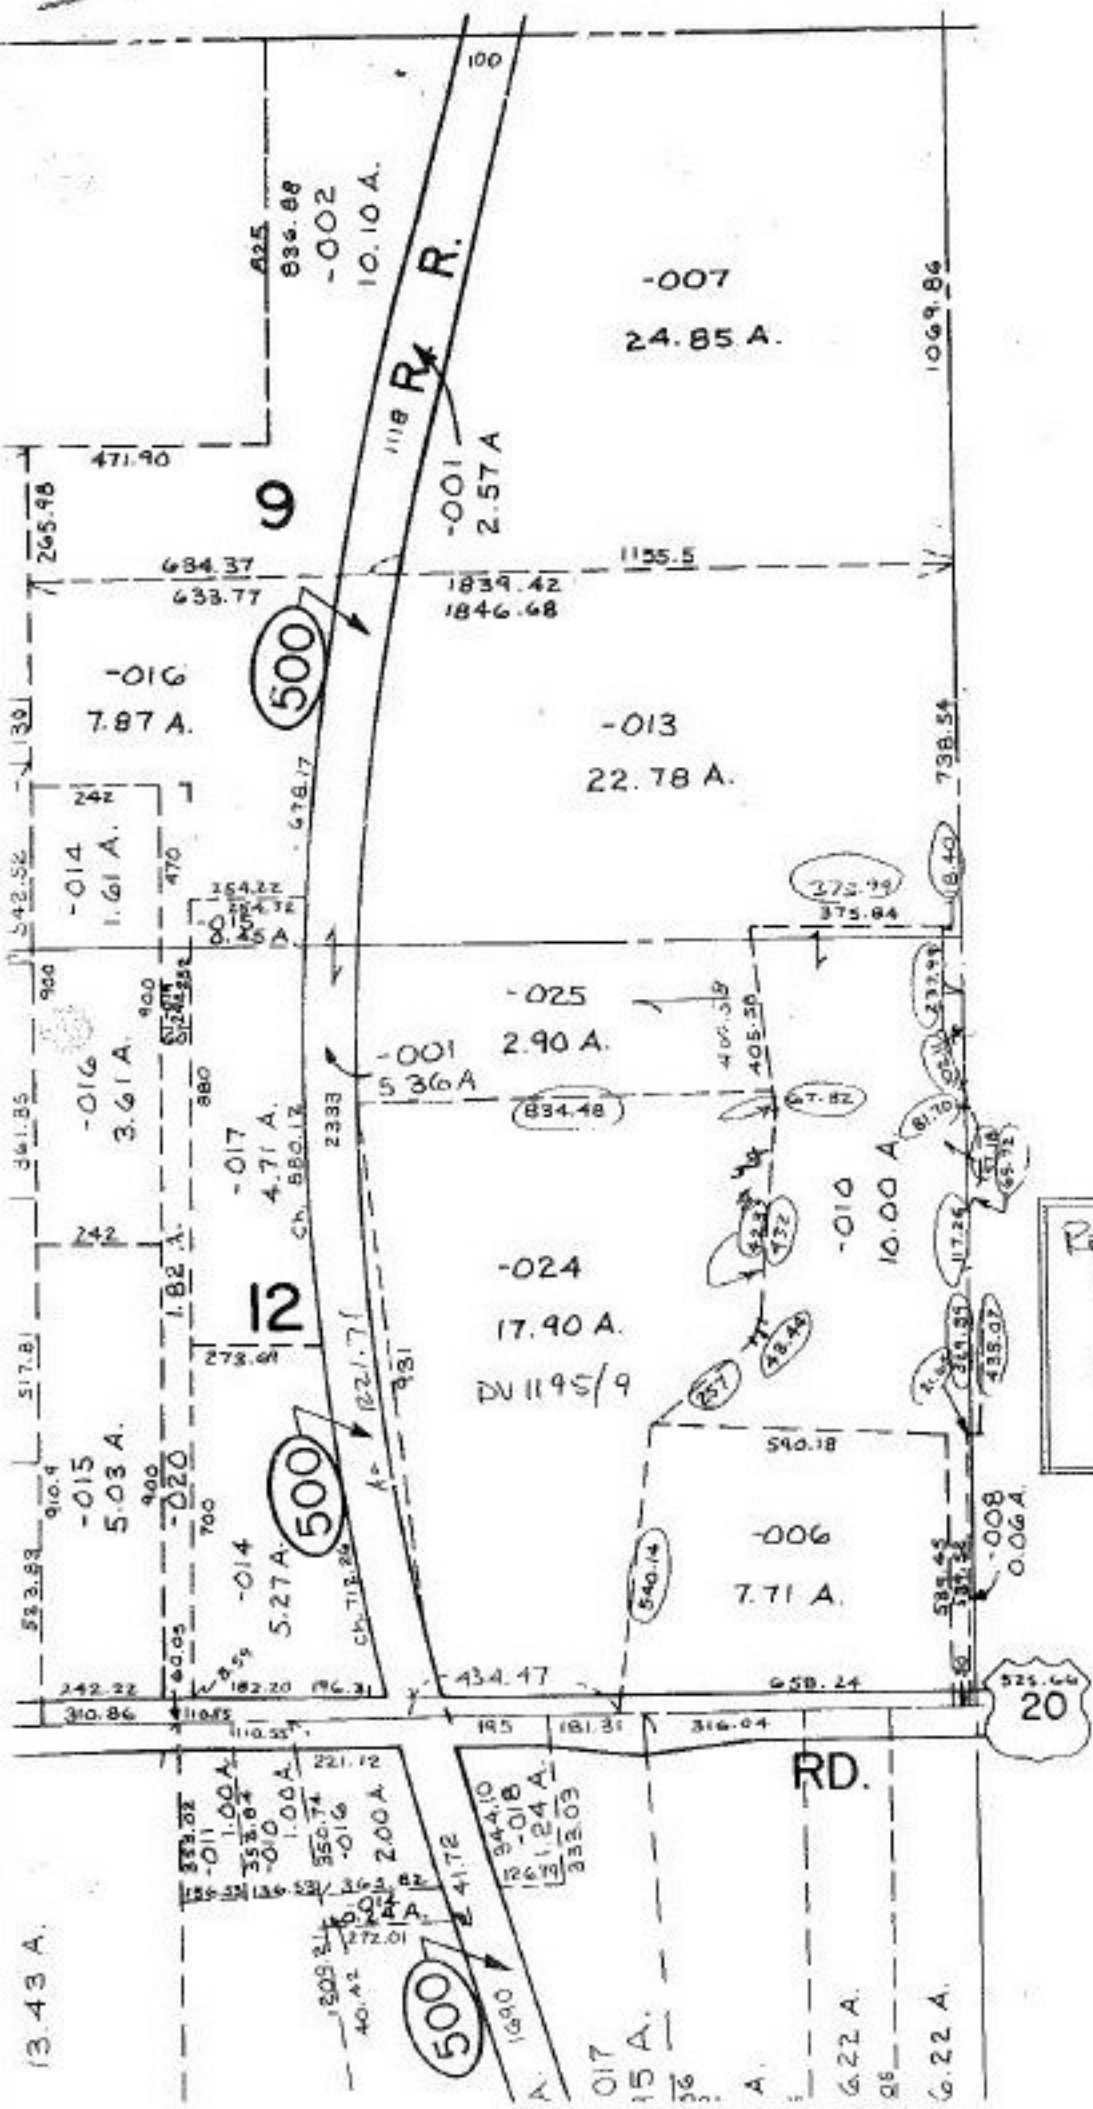

MAP CORRECTION ONLY: A LAND HOOK IS HOOK TO
 WRONG PARCEL. IT IS HOOK TO 14-00-012-000-024.
 IT SHOULD BE HOOKED TO 14-00-012-000-025.

REF -
 DV 1415/134
 C. PENFOUND SURVEY
 DV 1195/9

MAP CORR

21798-D

APPROVED
 LORAIN CO.
 MAP DEPT

DATE 6-12-96

PAGE 14-A

BY CAROLYN
 FRANCIS

21798-D