


SEE 5-00-081

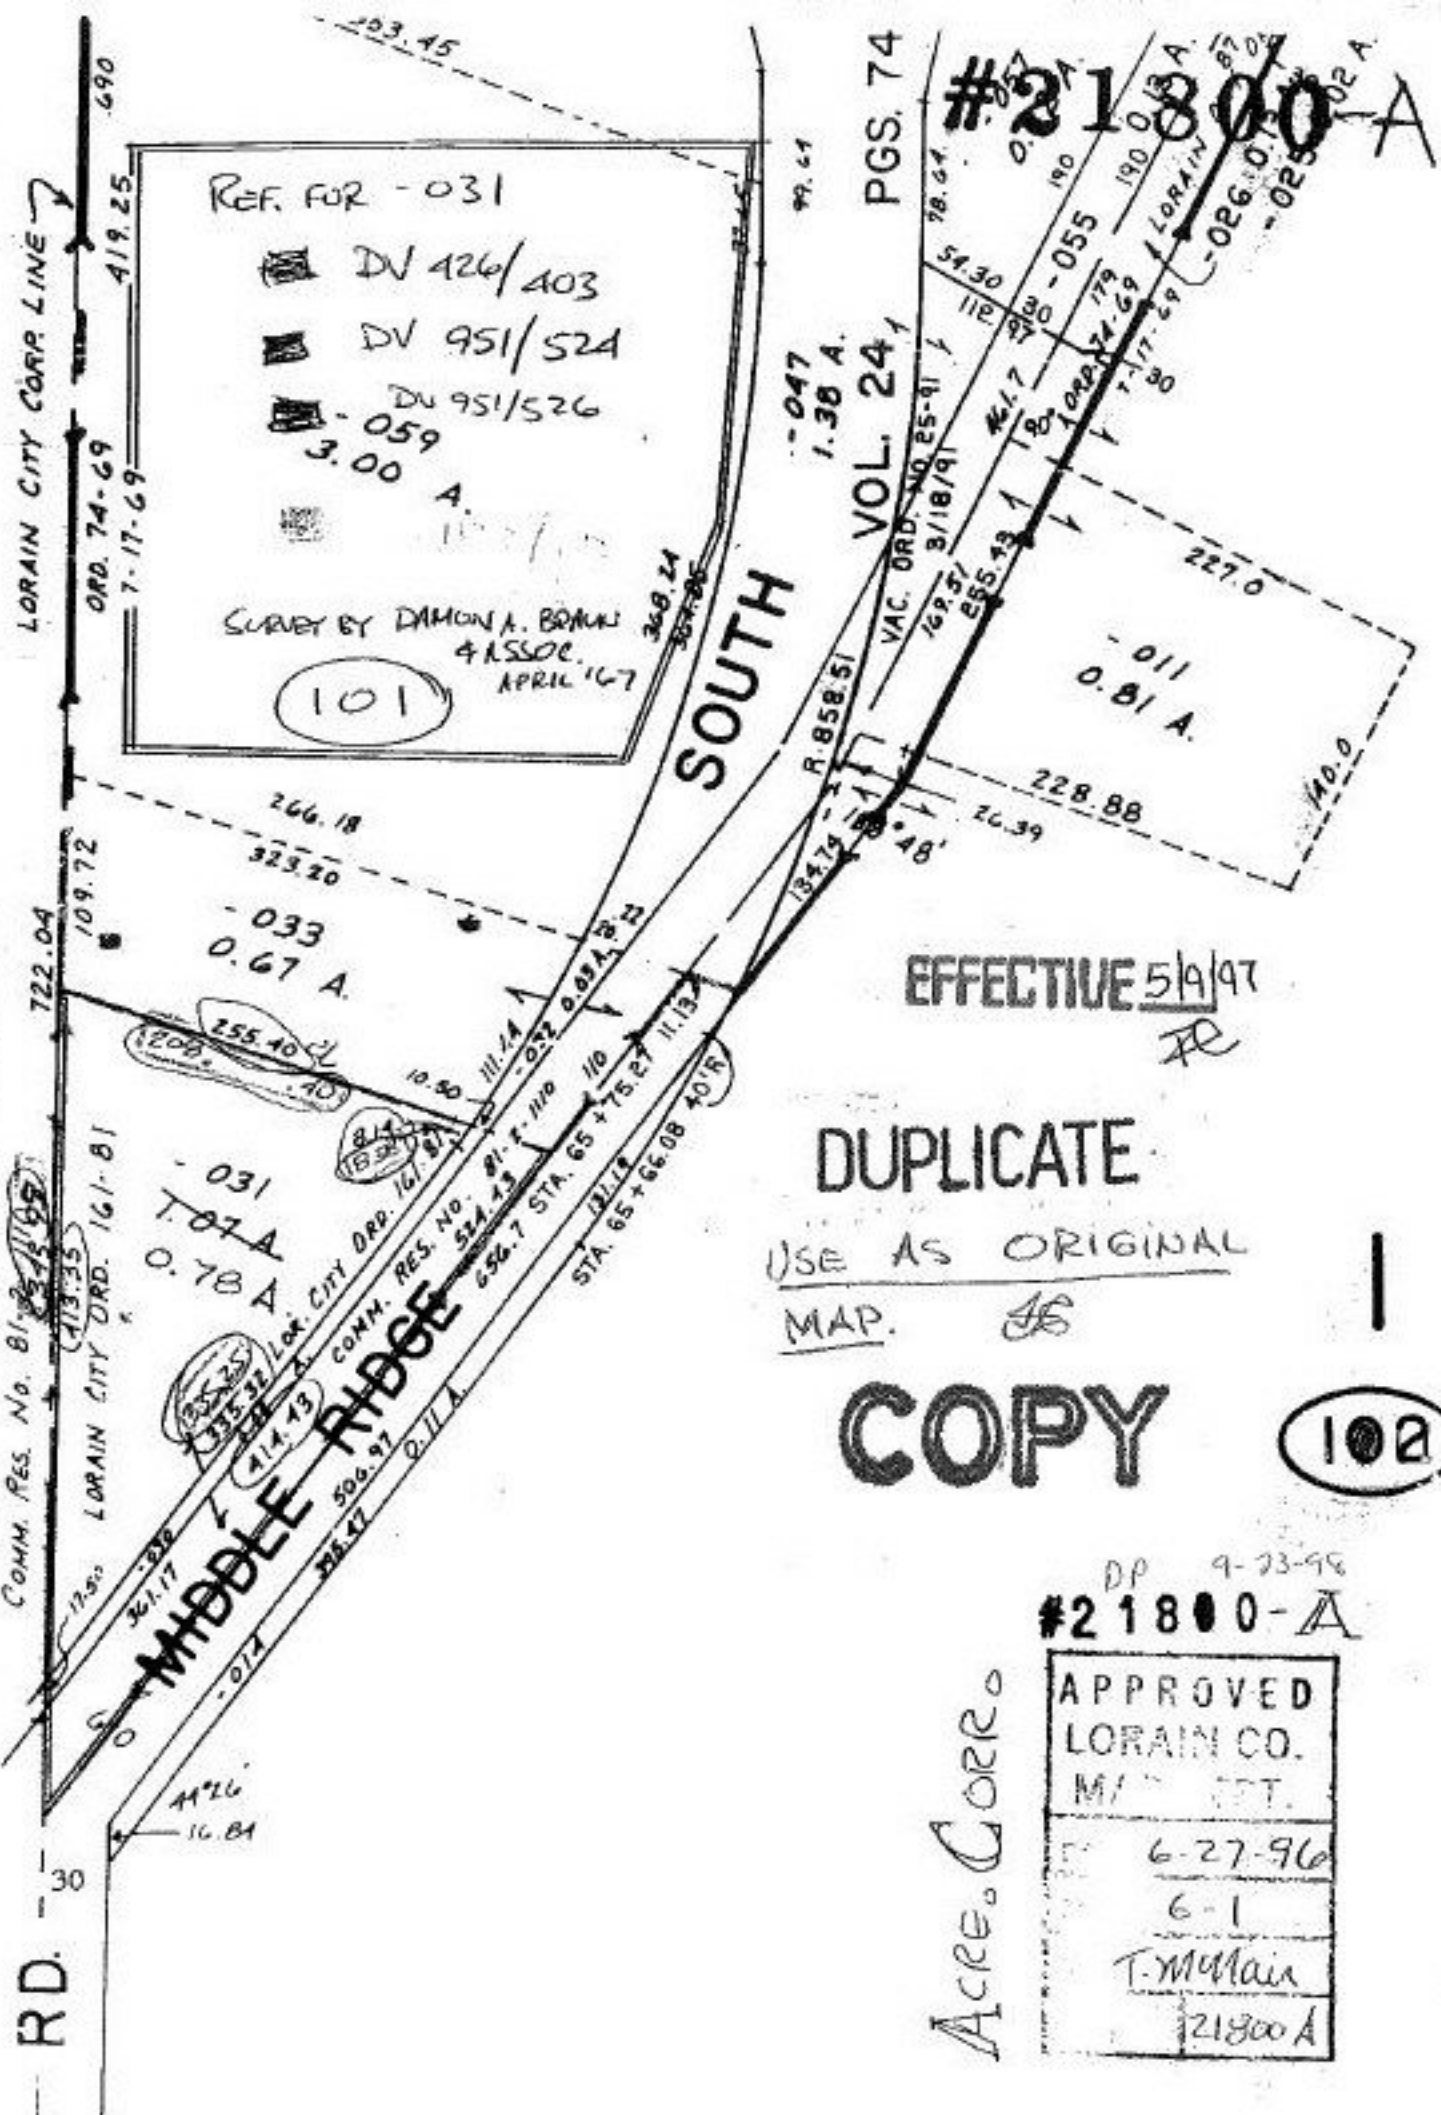

EFFECTIVE 5/9/97
JR

DUPLICATE
USE AS ORIGINAL
MAP. JS

COPY

102

DP 9-23-98
#21800-A

ACRE. CORR

APPROVED
LORAIN CO.
M/ T.
6-27-96
6-1
T. McMain
21800 A