


#21805

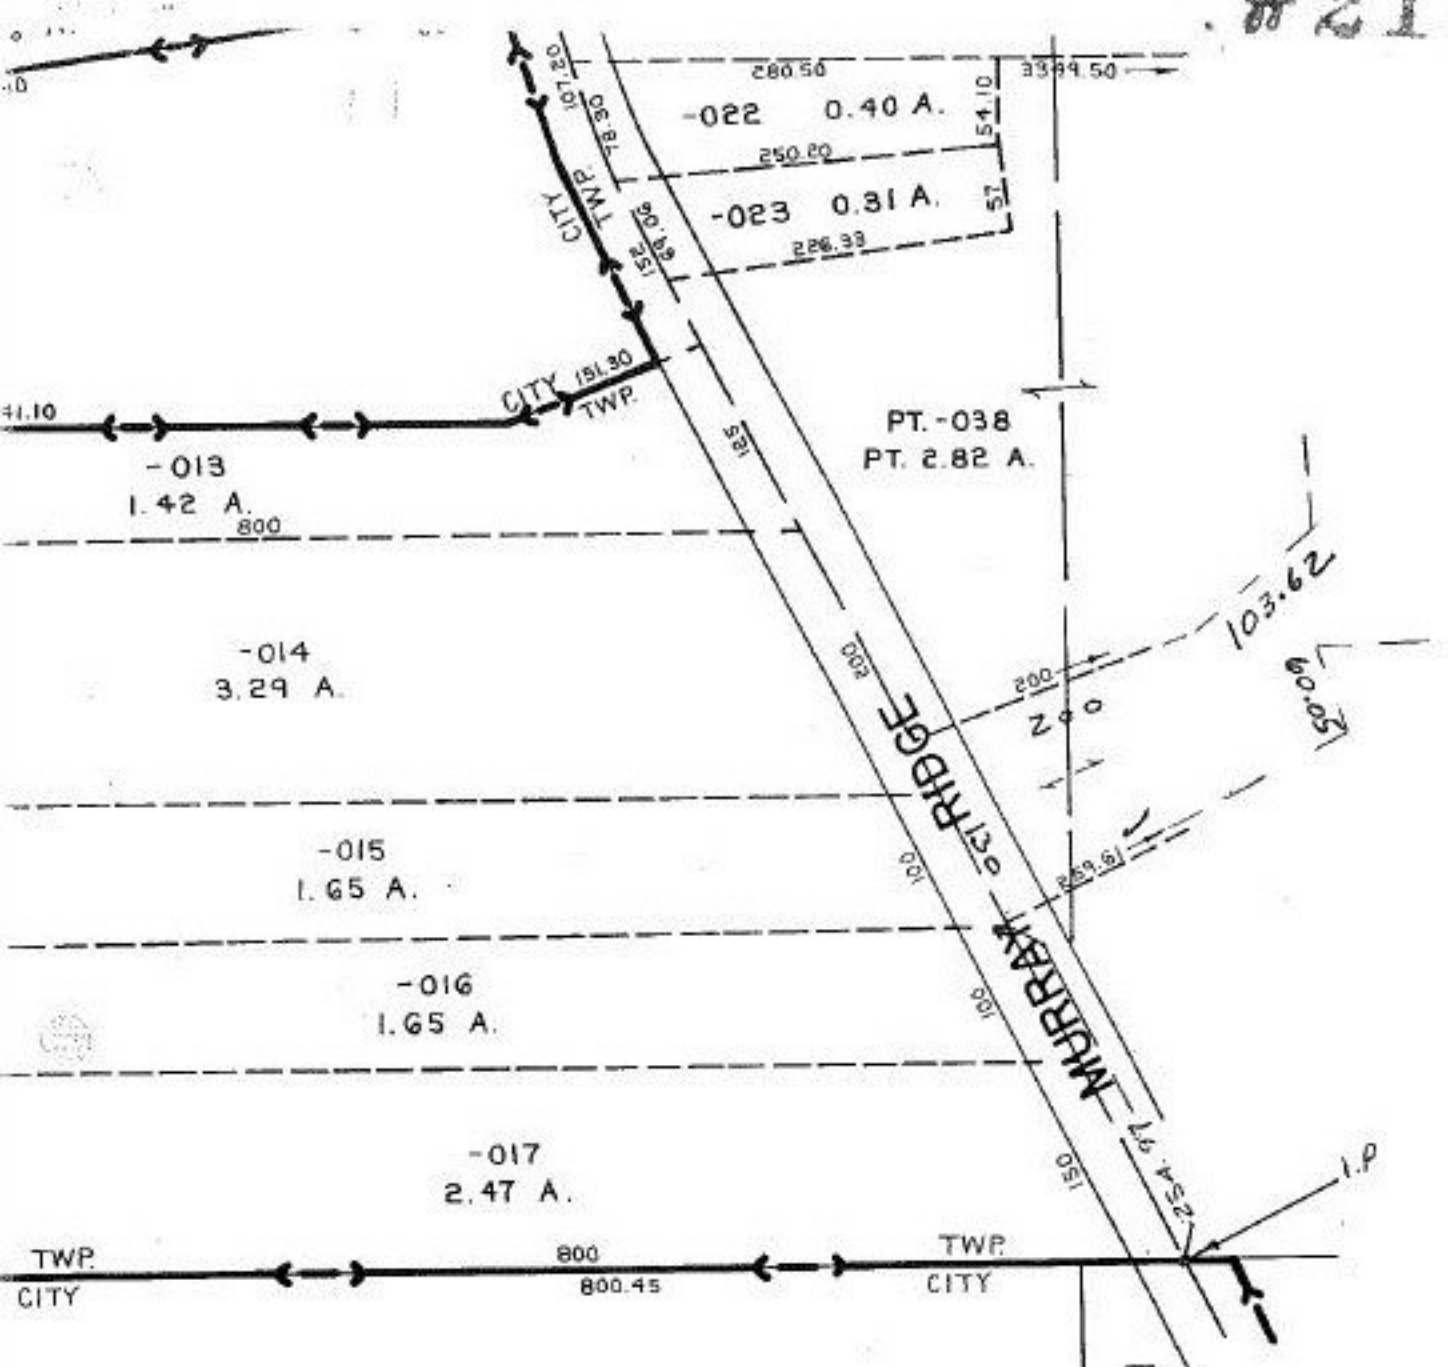

SEE 6-131

#21805

APPROVED	
LORAIN CO.	
MAP DEPT.	
DATE 6-25-96	
PAGE 6-130	
BY <i>[Signature]</i>	
VOID AFTER	21805