

65

#21812-X

OLD MAP REISSUED BY 11 & S.A. DETAIL

-001  
148.57A.

**NO CHANGES  
OF TAX MAP**



DESCRIPTIONS ARE ALREADY  
INCLUDED IN -004 3.00 A.?  
Pittsfield  
-011

ASHLAND - OBERLIN

HALLAUER

58

76

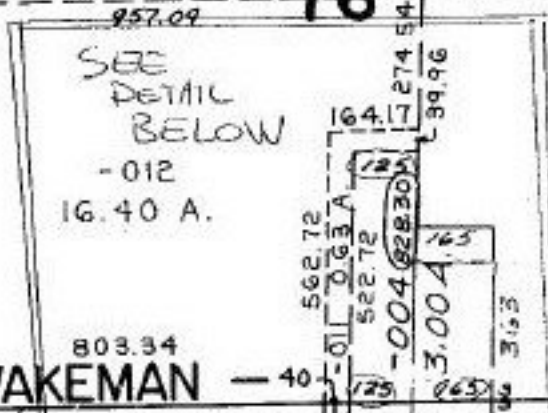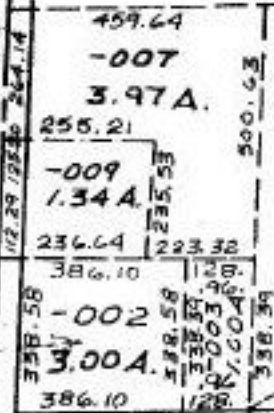


-005  
17.75 A.

-006  
2.00 A.

WAKEMAN - 40

BELDEN

303

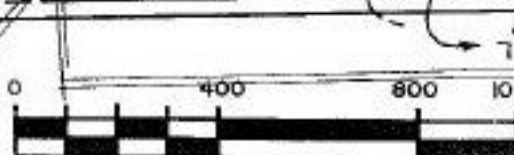

**PITTSFIE**

SCALE: 1" = 400'

**-C** 12-20-95  
REVISED

(A) DV 44, P. 59

(B) DV 141/258, 259


(C) OR 397, P. 270

(D) OR 1286/119

(E) LV 11, P. 418  
PRIOR TO 1911 (OLD MAPS)

SP 303

DETAIL 400' = 1"

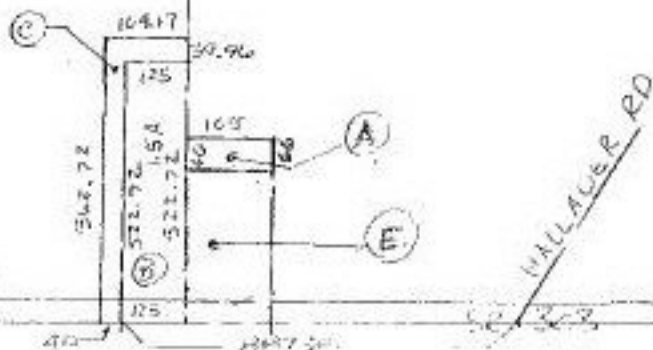

21812-X

APPROVED  
LORAIN CO.  
MAP DEPT.

DATE 12-9-96

PAGE 14-C

BY K. OYE

VOID AFTER # 21812-X